

CARD MUST BE TYPED

State of Kansas  
**NOTICE OF INTENTION TO DRILL**  
(see rules on reverse side)

CARD MUST BE SIGNED

Starting Date: 3/17/85  
month day year

API Number 15- 059-23,858-00-00

OPERATOR: License # 9607  
Name Max Painter  
Address 9865 Fairwood Lane  
City/State/Zip Memphis, TN 38119  
Contact Person Jim Mietchen  
Phone 316-242-2700

NW/4 (location) Sec 33 Twp 15 S, Rge 20  
3135 Ft North from Southeast Corner of Section  
2905 Ft West from Southeast Corner of Section  
(Note: Locate well on Section Plat on reverse side)

CONTRACTOR: License #  
Name Unknown  
City/State

Nearest lease or unit boundary line 265 feet.  
County Franklin  
Lease Name Pauline Scott Well# 28

Well Drilled For: Well Class: Type Equipment:  
 Oil  Swd  Infield  Mud Rotary  
 Gas  Inj  Pool Ext.  Air Rotary  
 OWWO  Expl  Wildcat  Cable

Domestic well within 330 feet:  yes  no  
Municipal well within one mile:  yes  no

If OWWO: old well info as follows:  
Operator  
Well Name  
Comp Date Old Total Depth  
Projected Total Depth 800 feet  
Projected Formation at TD  
Expected Producing Formations

Depth to Bottom of fresh water none feet  
Lowest usable water formation  
Depth to Bottom of usable water 200 feet  
Surface pipe by Alternate: 1  2   
Surface pipe to be set 40 feet  
Conductor pipe if any required feet  
Ground surface elevation feet MSL  
This Authorization Expires 9-11-85  
Approved By 3-11-85 [Signature]

I certify that we will comply with K.S.A. 55-101, et seq., plus eventually plugging hole to K.C.C. specifications.

Date 3/11/85 Signature of Operator or Agent [Signature] Title As. Agent

MHC/NOHE 3-11-85 Form C-1 4/84

Must be filed with the K.C.C. five (5) days prior to commencing well  
 This card void if drilling not started within six (6) months of date received by K.C.C.

Wichita, Kansas

MAR 1 1985


3-1-85

STATE CORPORATION COMMISSION

RECEIVED

A Regular Section of Land

1 Mile = 5,280 Ft.

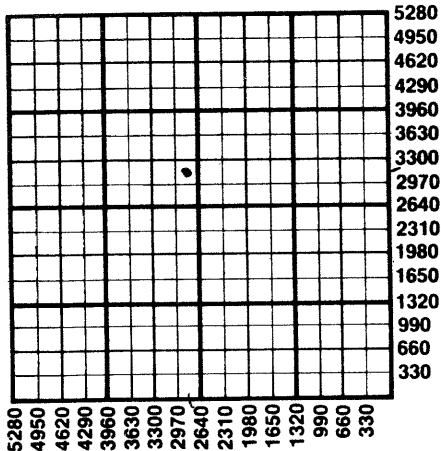

**Important procedures to follow:**

1. Notify District office before setting surface casing.
2. Set surface casing by circulating cement to the top.
3. File completion forms ACO-1 with K.C.C. within 90 days of well completion, following instructions on ACO-1, side 1, and including copies of wireline logs.
4. Notify District office 48 hours prior to old well workover or re-entry.
5. Prior to plugging, prepare a plugging plan, then obtain agreement from the appropriate district office for an approved plugging plan.
6. Submit plugging report (CP-4) to K.C.C. after plugging is completed.
7. Obtain an approved injection docket number before disposing of salt water.
8. Notify K.C.C. within 10 days when injection commences or terminates.
9. If an alternate 2 completion, cement in the production pipe from below any usable water to surface within 120 days of spud date.

State Corporation Commission of Kansas  
 Conservation Division  
 200 Colorado Derby Building  
 Wichita, Kansas 67202  
 (316) 263-3238