

CARD MUST BE TYPED

State of Kansas  
NOTICE OF INTENTION TO DRILL

CARD MUST BE SIGNED

(see rules on reverse side)

Starting Date: June 13 1985  
month day year

API Number 15- 059-23,927-00-00

OPERATOR: License # 9923

app <sup>NE</sup> NW NE Sec .33. Twp .15s, Rge .20  East  West

Name All Star Pumping, S.E.D.V.

Address Rt. 1, Box 42

City/State/Zip Pomona, KS 66076

Contact Person Jerry Hardsaw

Phone 913.242.5332

4785 Ft North from Southeast Corner of Section  
2475 Ft West from Southeast Corner of Section  
(Note: Locate well on Section Plat on reverse side)

CONTRACTOR: License # 6807

Name Oil Drillers & Developers

City/State 901 Garfield, Topeka, KS 66606

Nearest lease or unit boundary line 165 feet.  
County Franklin  
Lease Name Salisbury Well# 2

Well Drilled For: Well Class: Type Equipment:

- Oil  Swd  Infield  Mud Rotary
- Gas  Inj  Pool Ext.  Air Rotary
- OWWO  Expl  Wildcat  Cable

Domestic well within 330 feet:  yes  no  
Municipal well within one mile:  yes  no

If OWWO: old well info as follows:

Operator  
Well Name  
Comp Date Old Total Depth  
Projected Total Depth 800 feet  
Projected Formation at TD Squirrel  
Expected Producing Formations

Depth to Bottom of fresh water none feet  
Lowest usable water formation  
Depth to Bottom of usable water 200 feet  
Surface pipe by Alternate: 1  2   
Surface pipe to be set 40 feet  
Conductor pipe if any required feet  
Ground surface elevation feet MSL  
This Authorization Expires 12-11-85  
Approved By 6-4-85 R

I certify that we will comply with K.S.A. 55-101, et seq., plus eventually plugging hole to K.C.C. specifications.

Date 6/11/85 Signature of Operator or Agent Clairie Barham Title as agent

Form C-1 4/84


MHC/UDHE 6-11-85

Must be filed with the K.C.C. five (5) days prior to commencing well  
 This date void if drilling not started within six (6) months of date received by K.C.C.

NOISSINWMOJ  
 CONSERVATION DIVISION  
 JUN 1 1985

6-11-85

STATE CORPORATION COMMISSION  
 A Regular Section of Land  
 1 Mile = 5,280 Ft.

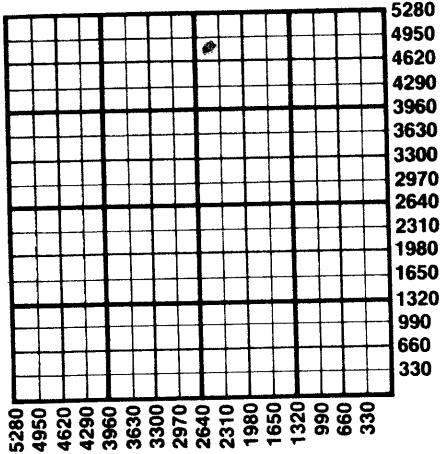

**Important procedures to follow:**

1. Notify District office before setting surface casing.
2. Set surface casing by circulating cement to the top.
3. File completion forms ACO-1 with K.C.C. within 90 days of well completion, following instructions on ACO-1, side 1, and including copies of wireline logs.
4. Notify District office 48 hours prior to old well workover or re-entry.
5. Prior to plugging, prepare a plugging plan, then obtain agreement from the appropriate district office for an approved plugging plan.
6. Submit plugging report (CP-4) to K.C.C. after plugging is completed.
7. Obtain an approved injection docket number before disposing of salt water.
8. Notify K.C.C. within 10 days when injection commences or terminates.
9. If an alternate 2 completion, cement in the production pipe from below any usable water to surface within 120 days of spud date.

**State Corporation Commission of Kansas  
 Conservation Division  
 200 Colorado Derby Building  
 Wichita, Kansas 67202  
 (316) 263-3238**