

CARD MUST BE TYPED

State of Kansas
NOTICE OF INTENTION TO DRILL
(see rules on reverse side)

CARD MUST BE SIGNED

Starting Date: June 14 1985
month day year 2:50

API Number 15- 059-23,929-00-00

OPERATOR: License # 9923
Name All Star Pumping Serv.
Address Rt. 1, Box 42
City/State/Zip Pomona, KS 66076
Contact Person Jerry Hardsaw
Phone 913 242 5332

app. SW NW NE X East
(location) Sec 33 Twp 15 S, Rge 20. 0 West

CONTRACTOR: License # 6807
Name Oil Drillers & Developers
City/State 901 Garfield, Topeka, KS 66606

..... 4125..... Ft North from Southeast Corner of Section
..... 2475..... Ft West from Southeast Corner of Section
(Note: Locate well on Section Plat on reverse side)

Well Drilled For: Well Class: Type Equipment:
 Oil Swd Infield Mud Rotary
 Gas Inj Pool Ext. Air Rotary
 OWWO Expl Wildcat Cable

Nearest lease or unit boundary line 165 feet.
County Franklin
Lease Name Salisbury Well# 4
Domestic well within 330 feet: yes no
Municipal well within one mile: yes no

If OWWO: old well info as follows:
Operator
Well Name
Comp Date Old Total Depth
Projected Total Depth 800 feet
Projected Formation at TD Squirrel
Expected Producing Formations

Depth to Bottom of fresh water none feet
Lowest usable water formation 200 feet
Depth to Bottom of usable water feet
Surface pipe by Alternate: 1 2
Surface pipe to be set 40 feet
Conductor pipe if any required feet
Ground surface elevation feet MSL
This Authorization Expires 12-11-85
Approved By 6-11-85 [Signature]

I certify that we will comply with K.S.A. 55-101, et seq., plus eventually plugging hole to K.C.C. specifications.

Date 6/11/85 Signature of Operator or Agent Elaine Parkman Title as agent

MHC/NOTE 6-11-85 Form C-1 4/84


Must be filed with the K.C.C. five (5) days prior to commencing well
 This card void if drilling not started within six (6) months of date received by K.C.C.

CONSERVATION DIVISION
 Wichita, Kansas

JUN 1 1985

6-11-85

NOISSIWWOJ NOILMHO
 A Regular Section of Land
 1 Mile - 3600 Ft.

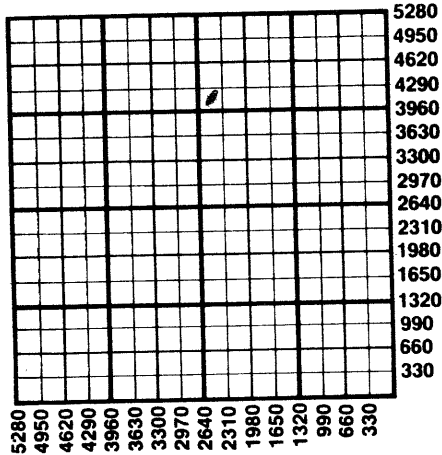

Important procedures to follow :

1. Notify District office before setting surface casing.
2. Set surface casing by circulating cement to the top.
3. File completion forms ACO-1 with K.C.C. within 90 days of well completion, following instructions on ACO-1, side 1, and including copies of wireline logs.
4. Notify District office 48 hours prior to old well workover or re-entry.
5. Prior to plugging, prepare a plugging plan, then obtain agreement from the appropriate district office for an approved plugging plan.
6. Submit plugging report (CP-4) to K.C.C. after plugging is completed.
7. Obtain an approved injection docket number before disposing of salt water.
8. Notify K.C.C. within 10 days when injection commences or terminates.
9. If an alternate 2 completion, cement in the production pipe from below any usable water to surface within 120 days of spud date.

State Corporation Commission of Kansas
 Conservation Division
 200 Colorado Derby Building
 Wichita, Kansas 67202
 (316) 263-3238