

CARD MUST BE TYPED

State of Kansas  
**NOTICE OF INTENTION TO DRILL**  
(see rules on reverse side)

CARD MUST BE SIGNED

Starting Date: ..... 7 ..... 17 ..... 85 .....  
month day year

API Number 15- 059-23 995-00-00

OPERATOR: License # 9873 *(W)*

SW NW NE Sec 33 Twp 15 S, Rge 20  East  West  
(location)

Name Painter Oil Co.

Address Rt. 2, Box 141 B

City/State/Zip Wellsville, KS 66092

Contact Person Max Painter

Phone 913 242-7310

CONTRACTOR: License # 5666

Name Finch's Drilling Inc.

City/State Rt. 2 Ottawa, KS 66067

Well Drilled For: Well Class: Type Equipment:

Oil  Swd  Anfield  Mud Rotary

Gas  Inj  Pool Ext.  Air Rotary

OWWO  Expl  Wildcat  Cable

If OWWO: old well info as follows:

Operator .....

Well Name .....

Comp Date ..... Old Total Depth .....

Projected Total Depth ..... 800 ..... feet

Projected Formation at TD ..... Squirrel .....

Expected Producing Formations .....

4125 Ft North from Southeast Corner of Section  
2145 Ft West from Southeast Corner of Section  
(Note: Locate well on Section Plat on reverse side)

Nearest lease or unit boundary line 495 feet.

County Franklin

Lease Name Salisbury Well# 7

Domestic well within 330 feet:  yes  no

Municipal well within one mile:  yes  no

Depth to Bottom of fresh water ..... None ..... feet

Lowest usable water formation Douglas Group .....

Depth to Bottom of usable water ..... 200 ..... feet

Surface pipe by Alternate: 1  2

Surface pipe to be set ..... 40 ..... feet

Conductor pipe if any required ..... feet

Ground surface elevation ..... feet MSL

This Authorization Expires 1-17-86

Approved By 7-17-85 *(Signature)*

I certify that we will comply with K.S.A. 55-101, et seq., plus eventually plugging hole to K.C.C. specifications.

Date 7/17/85 Signature of Operator or Agent

*(Signature: Susan Arnold)* Title

As agent

RECEIVED

STATE CORPORATION COMMISSION

Must be filed with the K.C.C. five (5) days prior to commencing well  
This card void if drilling not started within six (6) months of date received by K.C.C.

JUL 17 1985


7-17-85

CONSERVATION DIVISION

Wichita, Kansas

A Regular Section of Land

1 Mile = 5,280 Ft.

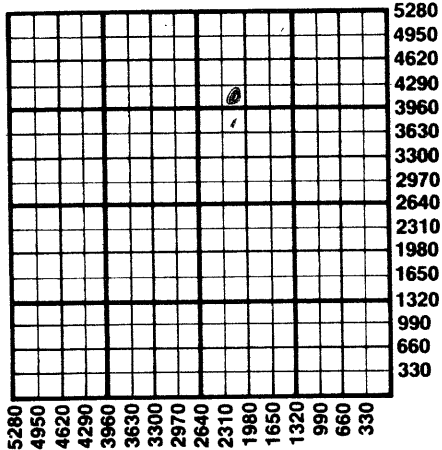

**Important procedures to follow :**

1. Notify District office before setting surface casing.
2. Set surface casing by circulating cement to the top.
3. File completion forms ACO-1 with K.C.C. within 90 days of well completion, following instructions on ACO-1, side 1, and including copies of wireline logs.
4. Notify District office 48 hours prior to old well workover or re-entry.
5. Prior to plugging, prepare a plugging plan, then obtain agreement from the appropriate district office for an approved plugging plan.
6. Submit plugging report (CP-4) to K.C.C. after plugging is completed.
7. Obtain an approved injection docket number before disposing of salt water.
8. Notify K.C.C. within 10 days when injection commences or terminates.
9. If an alternate 2 completion, cement in the production pipe from below any usable water to surface within 120 days of spud date.

State Corporation Commission of Kansas  
 Conservation Division  
 200 Colorado Derby Building  
 Wichita, Kansas 67202  
 (316) 263-3238