

CARD MUST BE SIGNED

(see rules on reverse side)

verse side)
API Number 15— 059-24,243-00-00
SW NW SE Sec. 33 Twp. 15S, Rg. 20 — East
1485 — West
2475
Ft. from South Line of Section
Ft. from East Line of Section

(Note: Locate well on Section Plat on reverse side)

Nearest lease or unit boundary line 165 feet

County Franklin

Lease Name Pauline Scott Well # 28

Ground surface elevation feet MSL

Domestic well within 330 feet: ___yes___ X no

Municipal well within one mile: ___yes___ X no

Depth to bottom of fresh water.....60
 Depth to bottom of usable water.....200
 Surface pipe by Alternate:.....1___2___X___
 Surface pipe planned to be set.....40

Conductor pipe required
 Projected Total Depth 850 feet
 Formation Squirrel

Date 6/17/87 Signature of Operator or Agent [Signature] Title AS ABUT


Conductor Pipe Required feet; Minimum Surface Pipe Required feet per Alt. *2*
This Authorization Expires *12-17-87* Approved By *6-17-87* *[Signature]*

Must be filed with the K.C.C. five (5) days prior to commencing well
This card void if drilling not started within six (6) months of date received by K.C.C.

Important procedures to follow:

1. Notify District office before setting surface casing.
2. Set surface casing by circulating cement to the top.
3. File completion forms ACO-1 with K.C.C. within 120 days of well spud date, following instructions on ACO-1, side 1, and including copies of wireline logs.
4. Notify District office 48 hours prior to old well workover or re-entry.
5. Prior to filing Intent, prepare a proposed plugging plan in case well is D & A, then obtain approval of plan when calling district office prior to setting surface pipe.
6. Submit plugging report (CP-4) to K.C.C. after plugging is completed.
7. Obtain an approved injection docket number before disposing of salt water.
8. Notify K.C.C. within 10 days when injection commences or terminates.
9. If an alternate 2 completion, cement in the production pipe from bottom to surface within 120 days of spud date.

A Regular Section of Land 1 Mile = 5,280 Ft.

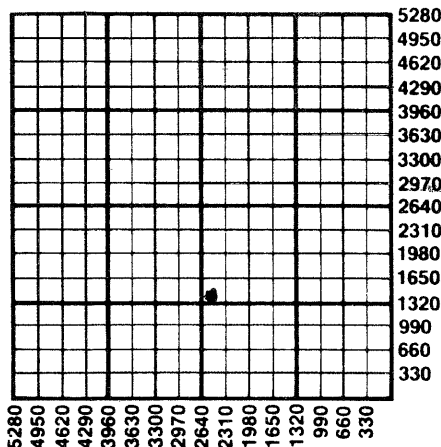

6-17-87

WICHITA, KANSAS
CONSERVATION DIVISION

MAILED
JUN 17 1987
State Corporation Commission of Kansas
Conservation Division
200 Colorado Derby Building
Wichita, Kansas 67202-1212
(316) 263-3238