

CARD MUST BE TYPED

State of Kansas

CARD MUST BE SIGNED

NOTICE OF INTENTION TO DRILL

(see rules on reverse side)

Starting Date Jan 21 1986
month day year

API Number 15- 059-24141-00-00

OPERATOR: License # 9873

C N2 NE NW

33

15

20

X East

Sec. Twp. S, Rg. West

Name Painter Oil Company, Inc.

Address Route 2, Box 141-B

City/State/Zip Wellsville, KS 66092

Contact Person Jerry Hardsaw

Phone 913-242-7310

(Note: Locate well on Section Plat on reverse side)

Nearest lease or unit boundary line 330 feet

County Franklin

Lease Name Pauline Scott Well # WI-4

CONTRACTOR: License # 6807

Name Oil Drillers & Dev., Inc.

City/State 7939 SW 29th, Topeka, KS 66614

Ground surface elevation feet MSL

Domestic well within 330 feet: yes no

Municipal well within one mile: yes no

Well Drilled For:

Well Class:

Type Equipment:

Oil SWD

Infill

Mud Rotary

Gas Inj

Pool Ext.

Air Rotary

OWWO ~~Exp~~

Wildcat

Cable

Depth to bottom of fresh water 25

Depth to bottom of usable water 200

Surface pipe by Alternate: 1 2

Surface pipe planned to be set 40

Conductor pipe required

Projected Total Depth 800 feet

Formation Squirrel

I certify that well will comply with K.S.A. 55-101, et seq., plus eventually plugging hole to KCC specifications.

Date 1/21/86 Signature of Operator or Agent

Glenn Bachman

Title as agent

For KCC Use:

Conductor Pipe Required feet; Minimum Surface Pipe Required 20' feet per Alt. 2

This Authorization Expires 7-21-86 Approved By 1-21-86 E


RC #1/10/86

Must be filed with the K.C.C. five (5) days prior to commencing well
 This card void if drilling not started within six (6) months of date received by K.C.C.

Important procedures to follow:

1. Notify District office before setting surface casing.
2. Set surface casing by circulating cement to the top.
3. File completion forms ACO-1 with K.C.C. within 90 days of well completion, following instructions on ACO-1, side 1, and including copies of wireline logs.
4. Notify District office 48 hours prior to old well workover or re-entry.
5. Prior to filing Intent, prepare a proposed plugging plan in case well is D & A, then obtain approval of plan when calling district office prior to setting surface pipe.
6. Submit plugging report (CP-4) to K.C.C. after plugging is completed.
7. Obtain an approved injection docket number before disposing of salt water.
8. Notify K.C.C. within 10 days when injection commences or terminates.
9. If an alternate 2 completion, cement in the production pipe from below any usable water to surface within 120 days of spud date.

A Regular Section of Land
 1 Mile = 5,280 Ft.

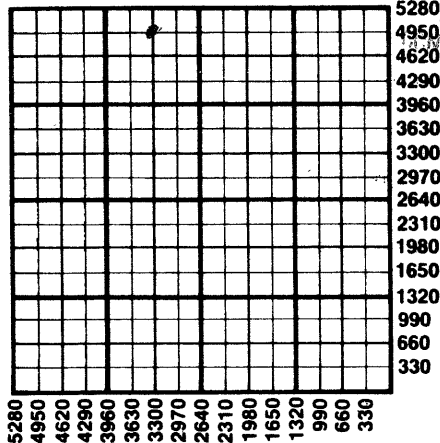

RECEIVED
 STATE CORPORATION COMMISSION

JAN 21 1986

CONSERVATION DIVISION
 Wichita, Kansas

1-21-86

State Corporation Commission of Kansas
 Conservation Division
 200 Colorado Derby Building
 Wichita, Kansas 67202
 (316) 263-3238