

CARD MUST BE TYPED

State of Kansas

CARD MUST BE SIGNED

NOTICE OF INTENTION TO DRILL

(see rules on reverse side)

Starting Date 01/02/87
month day year

API Number 15- 059-24200-00-00

OPERATOR: License # 9873

C W/2 NE NW Sec. 33 Twp. 15 S, Rg. 20 East

Name Painter Oil Company

Address Box 141 B, Route 2

City/State/Zip Wellsville, Kansas 66092

Contact Person Joe Smith

Phone (913) 242-7310

4620 Ft. from South Line of Section

3630 Ft. from East Line of Section

(Note: Locate well on Section Plat on reverse side)

Nearest lease or unit boundary line 330 feet

County Franklin

Lease Name Pauline Scott Well # 11

CONTRACTOR: License # 6807

Ground surface elevation na feet MSL

Name Oil Drillers & Developers, Inc.

City/State Topeka, Kansas

Domestic well within 330 feet: yes no

Well Drilled For: Well Class: Type Equipment:

Municipal well within one mile: yes no

Oil SWD Infield Mud Rotary

Depth to bottom of fresh water. 60

Gas Inj Pool Ext. Air Rotary

Depth to bottom of usable water 200

OWWO Expl Wildcat Cable

Surface pipe by Alternate: 1 2

If OWWO: old well info as follows:

Surface pipe planned to be set 40

Operator

Conductor pipe required na

Well Name

Projected Total Depth 800 feet

Comp Date Old Total Depth

Formation Squirrel

I certify that well will comply with K.S.A. 55-101, et seq., plus eventually plugging hole to KCC specifications.

Date 12/31/86 Signature of Operator or Agent Susan Arnold

Title As. Agent

For KCC Use:

Conductor Pipe Required feet; Minimum Surface Pipe Required

20 feet per Alt. 40

This Authorization Expires 7-1-87

Approved By 12-31-86


[Handwritten signature]

Must be filed with the K.C.C. five (5) days prior to commencing well
 This card void if drilling not started within six (6) months of date received by K.C.C.

Important procedures to follow:

1. Notify District office before setting surface casing.
2. Set surface casing by circulating cement to the top.
3. File completion forms ACO-1 with K.C.C. within 90 days of well completion, following instructions on ACO-1, side 1, and including copies of wireline logs.
4. Notify District office 48 hours prior to old well workover or re-entry.
5. Prior to filing Intent, prepare a proposed plugging plan in case well is D & A, then obtain approval of plan when calling district office prior to setting surface pipe.
6. Submit plugging report (CP-4) to K. C. C. after plugging is completed.
7. Obtain an approved injection docket number before disposing of salt water.
8. Notify K.C.C. within 10 days when injection commences or terminates.
9. If an alternate 2 completion, cement in the production pipe from below any usable water to surface within 120 days of spud date.

A Regular Section of Land
1 Mile = 5,280 Ft.

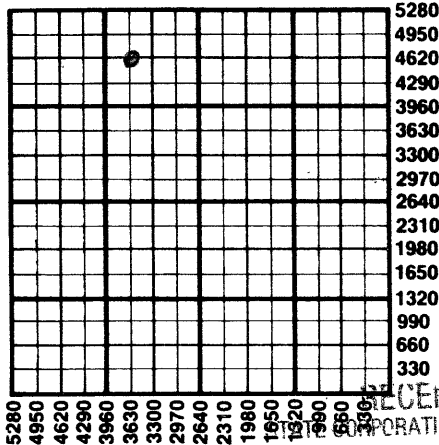

RECEIVED
 CORPORATION COMMISSION
 DEC 31 1986
 12-31-86
 CONSERVATION DIVISION
 Wichita, Kansas

State Corporation Commission of Kansas
 Conservation Division
 200 Colorado Derby Building
 Wichita, Kansas 67202
 (316) 263-3238