

CARD MUST BE TYPED

State of Kansas

CARD MUST BE SIGNED

NOTICE OF INTENTION TO DRILL

(see rules on reverse side)

Starting Date 01/03/87
month day year

API Number 15— 059-24,203-00-00

OPERATOR: License # 9873

..... C. E. 2 NW Sec. 33 Twp. 15 S, Rg. 20. — X East

Name Painter Oil Company

..... 3960 Ft. from South Line of Section

Address Box 141 B, Route 2

..... 3300 Ft. from East Line of Section

City/State/Zip Wellsville, Kansas 66092

(Note: Locate well on Section Plat on reverse side)

Contact Person Joe Smith

Nearest lease or unit boundary line 330 feet

Phone (913) 242-7310

County Franklin

CONTRACTOR: License # 6807

Lease Name Pauline Scott Well # 15

Name Oil Drillers & Developers, Inc

Ground surface elevation na feet MSL

City/State Topeka, Kansas

Domestic well within 330 feet: yes X no

Well Drilled For:

Well Class:

Type Equipment:

— Oil — SWD — X Infield — X Mud Rotary

Municipal well within one mile: yes X no

— Gas — Y Inj — Pool Ext. — Air Rotary

Depth to bottom of fresh water 60

— OWWO — Expl — Wildcat — Cable

Depth to bottom of usable water 200

If OWWO: old well info as follows:

Surface pipe by Alternate: 1 — 2 X

Operator

Surface pipe planned to be set 40

Well Name

Conductor pipe required na

Comp Date Old Total Depth

Projected Total Depth 800 feet

Formation Squirrel

I certify that well will comply with K.S.A. 55-101, et seq., plus eventually plugging hole to KCC specifications.

Date 12/31/86 Signature of Operator or Agent Susan Arnold Title As. Agent

For KCC Use:

Conductor Pipe Required feet; Minimum Surface Pipe Required 20 feet per Alt. 1 2

This Authorization Expires 2-1-87 Approved By 12-31-86


per per

Must be filed with the K.C.C. five (5) days prior to commencing well
This card void if drilling not started within six (6) months of date received by K.C.C.

Important procedures to follow:

1. Notify District office before setting surface casing.
2. Set surface casing by circulating cement to the top.
3. File completion forms ACO-1 with K.C.C. within 90 days of well completion, following instructions on ACO-1, side 1, and including copies of wireline logs.
4. Notify District office 48 hours prior to old well workover or re-entry.
5. Prior to filing Intent, prepare a proposed plugging plan in case well is D & A, then obtain approval of plan when calling district office prior to setting surface pipe.
6. Submit plugging report (CP-4) to K.C.C. after plugging is completed.
7. Obtain an approved injection docket number before disposing of salt water.
8. Notify K.C.C. within 10 days when injection commences or terminates.

**A Regular Section of Land
1 Mile = 5,280 Ft.**

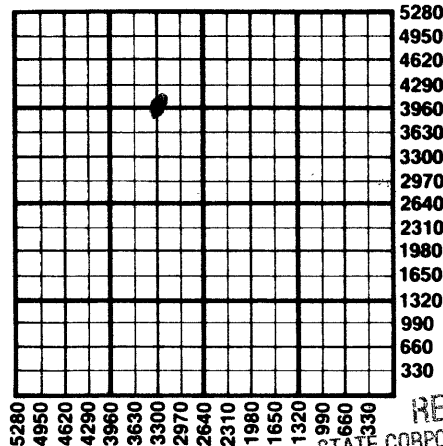

RECEIVED
STATE CORPORATION COMMISSION
DEC 31 1986
12-31-86
CONSERVATION DIVISION
Wichita, Kansas

If an alternate 2 completion, cement in the production pipe from below any usable water to surface within 120 days of spud date.

State Corporation Commission of Kansas
Conservation Division
200 Colorado Derby Building
Wichita, Kansas 67202
(316) 263-3238