

CARD MUST BE TYPED

State of Kansas
NOTICE OF INTENTION TO DRILL
(see rules on reverse side)

COLLECTED

CARD MUST BE SIGNED

11-16-84
*CORRECTED INTENT

Starting Date: * November 22, 1984
month day year

API Number 15- 163-22,561-00-00
(~~380 FNL, 3040 FWT~~)

OPERATOR: License # 5242
Name Petroleum Management, Inc.
Address 400 N. Woodlawn, Suite 201
City/State/Zip Wichita, KS 67208
Contact Person Dale Silcott
Phone 686-7287

NE. NW¹/₄ NW Sec 10. Twp 8. S, Rge 17. East
(location) West

CONTRACTOR: License # 5302
Name Red Tiger Drilling Co.
City/State Wichita, KS 67202

4.900 Ft North from Southeast Corner of Section
* 4.340 Ft West from Southeast Corner of Section
(Note: Locate well on Section Plat on reverse side)

Well Drilled For: Well Class: Type Equipment:
 Oil Swd Infield Mud Rotary
 Gas Inj Pool Ext. Air Rotary
 OWWO Expl Wildcat Cable

Nearest lease or unit boundary line 380 FNL feet.
County Rooks
Lease Name Head Well# 1

Domestic well within 330 feet: yes no
Municipal well within one mile: yes no

Depth to Bottom of fresh water 100 feet
Lowest usable water formation Dakota
Depth to Bottom of usable water ~~1125~~ 750 feet
Surface pipe by Alternate: 1 2
Surface pipe to be set 25.0 feet
Conductor pipe if any required _____ feet
Ground surface elevation 1920 feet MSL
This Authorization Expires 5-13-85
Approved By 11-13-84

If OWWO: old well info as follows:
Operator _____
Well Name _____
Comp Date _____ Old Total Depth _____
Projected Total Depth 3460 feet
Projected Formation at TD Lansing-K.C./Arbuckle
Expected Producing Formations Lansing-K.C./Arbuckle

kw as 4290 FEL

I certify that we will comply with K.S.A. 55-101, et seq., plus eventually plugging hole to K.C.C. specifications.
Date 11/14/84 Signature of Operator or Agent Dale Silcott Title Vice President

RECEIVED

STATE CORPORATION COMMISSION


Must be filed with the K.C.C. five (5) days prior to commencing well
This card void if drilling not started within six (6) months of date received by K.C.C.

NOV 16 1984
NOV 16 1984

WICHITA DISTRICT OFFICE

Wichita, Kansas

A Regular Section of Land
1 Mile = 5,280 Ft.

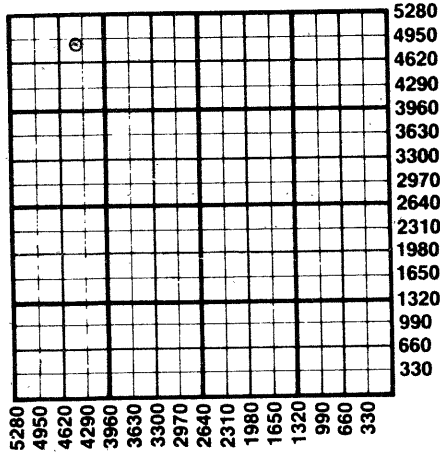

Important procedures to follow :

1. Notify District office before setting surface casing.
2. Set surface casing by circulating cement to the top.
3. File completion forms ACO-1 with K.C.C. within 90 days of well completion, following instructions on ACO-1, side 1, and including copies of wireline logs.
4. Notify District office 48 hours prior to old well workover or re-entry.
5. Prior to plugging, prepare a plugging plan, then obtain agreement from the appropriate district office for an approved plugging plan.
6. Submit plugging report (CP-4) to K.C.C. after plugging is completed.
7. Obtain an approved injection docket number before disposing of salt water.
8. Notify K.C.C. within 10 days when injection commences or terminates.
9. If an alternate 2 completion, cement in the production pipe from below any usable water to surface within 120 days of spud date.

State Corporation Commission of Kansas
Conservation Division
200 Colorado Derby Building
Wichita, Kansas 67202
(316) 263-3238