

CARD MUST BE TYPED

State of Kansas

CARD MUST BE SIGNED

NOTICE OF INTENTION TO DRILL

CORRECTION

DA

(see rules on reverse side)

Expected Spud Date... December 2, 1988
month day year

API Number 15- 163-23,028 -00-00

OPERATOR: License # 3701
Name BALCRON OIL COMPANY
Address P. O. Box 20174
City/State/Zip Billings, Montana 58104
Contact Person Alan Townsend
Phone 406/259-7860

— East
.C. SW. NE. Sec. 9... Twp. 8.. S, Rg. 17... X West
3300 Ft. from South Line of Section
1980 Ft. from East Line of Section

(Note: Locate well on Section Plat on reverse side)

CONTRACTOR: License # 5929
Name DUKE DRILLING CO., INC.
City/State Great Bend, Kansas 67530

Nearest lease or unit boundary line 330 feet
County Rooks

*** Lease Name Pittman Well # 1-9 ***

Well Drilled For: Well Class: Type Equipment:
X Oil Storage X Infield X Mud Rotary
Gas Inj Pool Ext Air Rotary
OWWO Expl Wildcat Cable

Ground surface elevation feet MSL

Domestic well within 330 feet: yes X no

Municipal well within one mile: yes X no

Depth to bottom of fresh water 100

Depth to bottom of usable water 850

Surface pipe by Alternate: 1 2 X

If OWWO: old well info as follows:

Surface pipe planned to be set 200

Operator
Well Name
Comp Date Old Total Depth

Conductor pipe required

Projected Total Depth 3400 feet

Formation Arbuckle

I certify that well will comply with K.S.A. 55-101, et seq., plus eventually plugging hole to KCC specifications.

Date 12/1/88 Signature of Operator or Agent James B. Phillips Title Agent

For KCC Use:

Conductor Pipe Required feet; Minimum Surface Pipe Required 200' feet per Alt. X (2)

This Authorization Expires 5-23-89 Approved By LKM 12-6-88 ORIG. RCVD: 11-23-88


*** WAS: Lone Star #1-9 EFFECTIVE DATE: 11-28-88

Must be filed with the K.C.C. five (5) days prior to commencing well
This card void if drilling not started within six (6) months of date received by K.C.C.

Important procedures to follow:

1. Notify District office before setting surface casing.
2. Set surface casing by circulating cement to the top.
3. File completion forms ACO-1 with K.C.C. within 120 days of well spud date, following instructions on ACO-1, side 1, and including copies of wireline logs.
4. Notify District office 48 hours prior to old well workover or re-entry.
5. Prior to filing Intent, prepare a proposed plugging plan in case well is D & A, then obtain approval of plan when calling district office prior to setting surface pipe.
6. Submit plugging report (CP-4) to K.C.C. after plugging is completed.
7. Obtain an approved injection docket number before disposing of salt water.
8. Notify K.C.C. within 10 days when injection commences or terminates.
9. If an alternate 2 completion, cement in the production pipe from below any usable water to surface within 120 days of spud date.

A Regular Section of Land
1 Mile = 5,280 Ft.

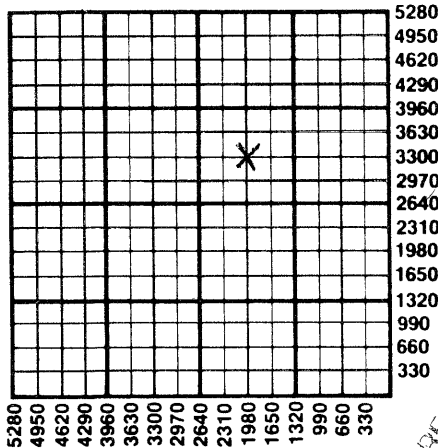

RECEIVED
STATE CORPORATION COMMISSION
DEC 5 1988
CONSERVATION DIVISION
Wichita, Kansas

State Corporation Commission of Kansas
Conservation Division
200 Colorado Derby Building
Wichita, Kansas 67202-1212
(316) 263-3238