


Give All Information Completely
Make Required Affidavit
Mail or Deliver Report to:
Conservation Division
State Corporation Commission
211 No. Broadway
Wichita, Kansas

WELL PLUGGING RECORD

NORTH

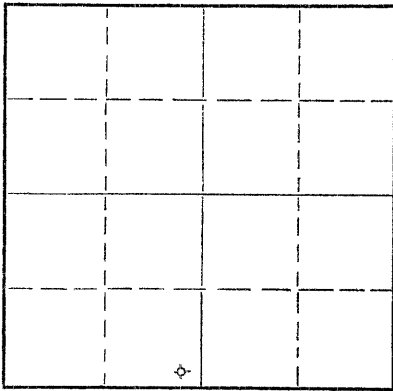

Locate well correctly on above
Section Plat

Rooks

County. Sec. 8 Twp. 8 Rge. 17 (E) W (W)

Location as "NE/CNW%SW%" or footage from lines SE/4 SE/4 SW/4

Lease Owner R. P. Nixon

Lease Name Schindler "A" Well No. 1

Office Address 754 E. Wichita Avenue-Russell, Kansas

Character of Well (completed as Oil, Gas or Dry Hole) Dry Hole

Date well completed June 17 19 56

Application for plugging filed June 16 19 56

Application for plugging approved June 16 19 56

Plugging commenced June 16 19 56

Plugging completed June 17 19 56

Reason for abandonment of well or producing formation Dry Hole

If a producing well is abandoned, date of last production 19

Was permission obtained from the Conservation Division or its agents before plugging was commenced?

Name of Conservation Agent who supervised plugging of this well Eldon Petty

Producing formation Depth to top Bottom Total Depth of Well 3335 Feet

Show depth and thickness of all water, oil and gas formations.

OIL, GAS OR WATER RECORDS

CASING RECORD

FORMATION	CONTENT	FROM	TO	SIZE	PUT IN	PULLED OUT
				8 5/8	200'	Cmtd 100 saxe

Describe in detail the manner in which the well was plugged, indicating where the mud fluid was placed and the method or methods used in introducing it into the hole. If cement or other plugs were used, state the character of same and depth placed, from feet to feet for each plug set.

Load hole w/ heavy mud, put Halliburton plug ahead of cement,
Squeeze 8 5/8" surface w/ 60 saxe common cement w/400# max. pressure

JUN 20, 1956

Name of Plugging Contractor Shields Drilling Company, Inc.
Address Shields Building, Russell, Kansas

STATE OF Kansas, COUNTY OF Russell, ss. R. J. Shields, Contractor

well, being first duly sworn on oath, says: That I have knowledge of the facts, statements, and matters herein contained and the log of the above-described well as filed and that the same are true and correct. So help me God.

(Signature) [Signature] Shields Bldg. - Russell, Kansas (Address)

SUBSCRIBED AND SWORN TO before me this 18 day of June, 19 56

My commission expires 12-18-1957 Jack P. Beeman Notary Public.

PLUGGING
FILE SEC 8 T 8 R 17W
BOOK PAGE 72 LINE 36



Shields


15-163-19109-00-00

Russell, Kansas

WELL LOG

Operator R. P. Nixon
 Well Schindler "A" #1
 Commenced June 7, 1956
 Completed June 17, 1956
 Contractor Shields Drilling Company, Inc.

Well Description. SE SE SW
 Sec. 8-8-17W
 Rooks County, Ks.

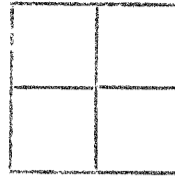

Elevation: 1860' RB

Treatment:

Production: D & A

Tops: Heebner 2977'
 Lansing-KC 3019'
 Arbuckle 3300'

CASING RECORD

Size	Run	Pulled
8 5/8"	200'	Cmtd. w/ 100 sax

Figures Indicate Bottom of Formations

Surface Soil	30
Sand	40
Lime & Shale	200
Shale	500
Sand & Shale	950
Shale & Red Bed	1050
Sand & Shale	1330
Shale	1650
Shale & Shells	2095
Shale & Lime	2290
Lime & Shale	2670
Shale & Lime	2820
Lime & Shale	2930
Lime	3335

RTD

PLUGGING

FILE SEC 8 T 8 R 17W
 BOOK PAGE 72 LINE 36

JUN 20, 1956

DST #1 3115-26 Tool open 15 min. Weak blow for 3 min. Recovered 8' mud. BHP-610#/20 min.
 DST #2 3302-06 Tool open 15 min. Recovered 2' drilling mud. BHP-40#/20 min.
 DST #3 3306-16 Tool open 15 min. Weak blow for 3 min. Recovered 3' mud w/ few specks oil. BHP-300#/20 min.

Notes

DST #4 3316-26 Tool open 15 min. Recovered 6' mud. BHP-150#/20 min.
 DST #5 3326-35 Tool open 15 min. Recovered 12' mud. BHP-265#/20 min.