


STATE OF KANSAS
STATE CORPORATION, COMMISSION

Give All Information Completely
Make Required Affidavit
Mail or Deliver Report to:
Conservation Division
State Corporation Commission
211 No. Broadway
Wichita, Kansas

WELL PLUGGING RECORD

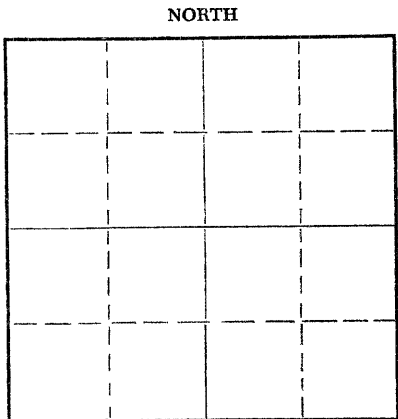

Locate well correctly on above
Section Plat

Rooks County. Sec. 8 Twp. 8S Rge. 17W (X) (W)
Location as "NE/CNW/SW" or footage from lines NE 1/4 NE 1/4 SW 1/4
Lease Owner Okmar Oil Company
Lease Name Schindler Well No. 1
Office Address 817 Union National Bldg., Wichita, Kansas
Character of Well (completed as Oil, Gas or Dry Hole) Dry Hole
Date well completed 4-28-58 19__
Application for plugging filed 4-28-58 19__
Application for plugging approved 4-28-58 19__
Plugging commenced 4-28-58 19__
Plugging completed 4-28-58 19__
Reason for abandonment of well or producing formation Dry Hole

If a producing well is abandoned, date of last production -- 19__
Was permission obtained from the Conservation Division or its agents before plugging was commenced? yes

Name of Conservation Agent who supervised plugging of this well A. D. Fabricius
Producing formation _____ Depth to top _____ Bottom _____ Total Depth of Well 3327' Feet
Show depth and thickness of all water, oil and gas formations.

OIL, GAS OR WATER RECORDS

CASING RECORD

FORMATION	CONTENT	FROM	TO	SIZE	PUT IN	PULLED OUT
				8 5/8"	132'	

Describe in detail the manner in which the well was plugged, indicating where the mud fluid was placed and the method or methods used in introducing it into the hole. If cement or other plugs were used, state the character of same and depth placed, from _____ feet to _____ feet for each plug set.

Squeezed the well with 100 sacks cement by pressuring up with pump truck on top.

(If additional description is necessary, use BACK of this sheet)

Name of Plugging Contractor Leben Drilling, Inc.
Address 905 Central Bldg., Wichita, Kansas

STATE OF Kansas, COUNTY OF Sedgwick
L. Frank Hamlin (employee of ~~owner~~ Contractor or (owner or operator) of the above-described well, being first duly sworn on oath, says: That I have knowledge of the facts, statements, and matters herein contained and the log of the above-described well as filed and that the same are true and correct. So help me God.

(Signature) Frank Hamlin
905 Central Bldg., Wichita, Kansas
(Address)

SUBSCRIBED AND SWORN to before me this 30th day of April, 1958

My commission expires June 17, 1961

Ruth N. Benjamin
Notary Public.

PLUGGING
FILE SEC. 8 T. 8 R. 17W
BOOK PAGE 98 LINE 33

MAY 15 1958

DRILLER'S LOG

COMPANY: OGNAR OIL COMPANY
 CONTRACTOR: LEBEN DRILLING, INC.
 FARM: SCHINDLER #1
 LOCATION: SE NE SW⁴ SEC. 8-25-17W
 ROCKS COUNTY, KANSAS
 COMMENCED: 4-19-58
 COMPLETED: 4-23-58

0	490	Shale & Shells	
490	950	Sand & Shale	
950	1130	Sand & Shale	TOPS
1130	1240	Redbed & Shale	
1240	1260	Sand & Shale	Anhydrite 1225
1260	1280	Sand, Shale & Pyrite	Topoka 2750
1280	1745	Shale & Shells	Hobner 2971
1745	2320	Lime & Shale	Toronto 2902
2320	2590	Lime & Shale	Leaning 3012
2590	3015	Lime & Shale	Conglomerate 3294
3015	3062	Lime	Arbuckle 3209
3062	3225	Lime & Shale	
3225	3280	Lime	Elevation 1951 K.S.
3280	3300	Lime & Shale	
3300	3327	Arbuckle	
	3327	Rotary Total Depth - B & A	

Set 132' of 8 5/8" surface casing with 100 sacks cement & 2% CaCl.

I, Frank Hamlin, do hereby certify that the above and foregoing is a true and correct copy of the log of the Schindler #1, located NE 1/4 NE 1/4 SW 1/4 of Section 8, Township 8 South, Range 17 West, Rocks County, Kansas, as reflected by the files of Leben Drilling, Inc.

LEBEN DRILLING, INC.

By: Frank Hamlin
 Frank Hamlin

STATE OF KANSAS }
 COUNTY OF SEDGWICK } ss:

Subscribed and sworn to before me, a Notary Public, in and for Sedgwick County, Kansas, this 5th day of May, 1958.

Richard Benjamin
 Notary Public

My commission expires:

June 17, 1961

RECEIVED
 STATE OF KANSAS DEPARTMENT OF

MAY 15 1958
 MAY 15 1958
 CONSERVATION DIVISION
 Wichita, Kansas

PLUGGING
 FILE SEC 8 T 8 R 17W
 BOOK PAGE 98 LINE 33