


STATE OF KANSAS
STATE CORPORATION COMMISSION

WELL PLUGGING RECORD

Give All Information Completely
Make Required Affidavit
Mail or Deliver Report to
Conservation Division
State Corporation Comm.
245 North Water
Wichita, KS 67202

Rooks County, Sec. 8 Twp. 8S Rge. 17 E/W
Location as "NE/CNW{SW}" or footage from lines
NE/4 SW/4 SW/4
Lease Owner George P. Crawford
Lease Name Cooper Well No. #1
Office Address 926 4th St. Natoma, Kansas 67651
Character of Well (Completed as Oil, Gas or Dry Hole)
Dry Hole
Date Well completed June 10, 1980
Application for plugging filed June 10, 1980
Application for plugging approved June 10, 1980
Plugging commenced June 10, 2:30 P.M. 1980
Plugging completed June 10, 4:00 P.M. 1980
Reason for abandonment of well or producing formation
No Commercial Production

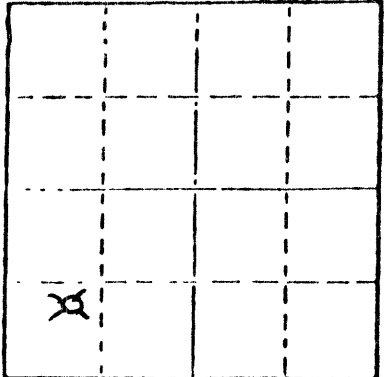

If a producing well is abandoned, date of last production 19
Was permission obtained from the Conservation Division or its agents before plugging was commenced? yes

Name of Conservation Agent who supervised plugging of this well Marion Schmidt
Producing formation Depth to top Bottom Total Depth of Well
Show depth and thickness of all water, oil and gas formations.

GIL, GAS OR WATER RECORDS

CASING RECORD

FORMATION	CONTENT	FROM	TO	SIZE	PUT IN	PULLED OUT
no surface casing set						

Describe in detail the manner in which the well was plugged, indicating where the mud fluid was placed and the method or methods used in introducing it into the hold. If cement or other plugs were used, state the character of same and depth placed, from feet to feet for each plug set.

Plugged with 320 sxs 50-50 poz with 6% gel
& 10 sxs hulls, 5 sxs in rat hole
325 sxs total plug

RECEIVED
STATE CORPORATION COMMISSION
JUL 29 1980
JUL 29 1980

(If additional description is necessary, use BACK of this sheet)

Name of Plugging Contractor Pioneer Drilling Company, Inc.
308 West Mill Plainville, Kansas 67663


X STATE OF KANSAS COUNTY OF ROOKS, ss.
GEO. P. CRAWFORD (employee of owner) or (owner or operator)

of the above-described well, being first duly sworn on oath, says: That I have knowledge of the facts, statements, and matters herein contained and the log of the above-described well as filed and that the same are true and correct. So help me God.

(Signature) George P. Crawford
926 4th St., Natoma, Ks 67651
(Address)

SUBSCRIBED AND SWORN TO before me this day of 19

My commission expires

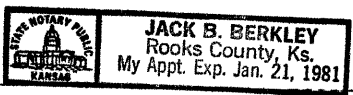

Jack B. Berkley
Notary Public.