


Give All Information Completely  
Make Required Affidavit  
Mail or Deliver Report to:  
Conservation Division  
State Corporation Commission  
P. O. Box 17027  
Wichita, Kansas 67217  
NORTH

WELL PLUGGING RECORD

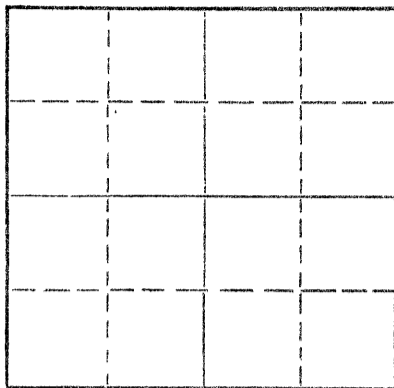

Locate well correctly on above Section Plat

Rooks County, Sec. 16 Twp. 8 Rge. 17 (E) W (W)  
Location as "NE/CNW%SW%" or footage from lines NE/4 NE/4 SE/4  
Lease Owner Black Petroleum Co.  
Lease Name Schindler Well No. 1  
Office Address Suite 545 Garvey Building  
Character of Well (completed as Oil, Gas or Dry Hole) Dry hole  
Date well completed 5-31-74  
Application for plugging filed 5-31-74  
Application for plugging approved 5-31-74  
Plugging commenced 5-31-74  
Plugging completed 5-31-74  
Reason for abandonment of well or producing formation Dry hole

If a producing well is abandoned, date of last production 19\_\_\_\_  
Was permission obtained from the Conservation Division or its agents before plugging was commenced? Yes

Name of Conservation Agent who supervised plugging of this well Leo Massey  
Producing formation \_\_\_\_\_ Depth to top \_\_\_\_\_ Bottom \_\_\_\_\_ Total Depth of Well 3,450 Feet  
Show depth and thickness of all water, oil and gas formations.

OIL, GAS OR WATER RECORDS

CASING RECORD

FORMATION	CONTENT	FROM	TO	SIZE	PUT IN	PULLED OUT
				8 5/8"	284'	Cmtd. w/150 sax

Describe in detail the manner in which the well was plugged, indicating where the mud fluid was placed and the method or methods used in introducing it into the hole. If cement or other plugs were used, state the character of same and depth placed, from \_\_\_\_\_ feet to \_\_\_\_\_ feet for each plug set.

Fill hole w/heavy mud  
Set bridge plug @600'  
Pump 70 sax cement on plug thru 4 1/2" drill pipe  
Fill hole w/heavy mud  
Set bridge plug @240'  
Pump 20 sax cement on plug thru 4 1/2" drill pipe  
Set bridge plug @40' w/1/2 sax hulls on plug  
Dump 10 sax cement on plug to cellar

RECEIVED  
STATE CORPORATION COMMISSION  
JUN 25 1974  
JUN 25 1974  
CONSERVATION DIVISION  
Wichita, Kansas

(If additional description is necessary, use BACK of this sheet)

Name of Plugging Contractor Shields Drilling Co., Inc.  
Address Shields Bldg., Russell, Kansas

STATE OF KANSAS, COUNTY OF RUSSELL, ss. R. L. Shields (employee of owner) or (owner or operator) contractor of the above-described well, being first duly sworn on oath, says: That I have knowledge of the facts, statements, and matters herein contained and the log of the above-described well as filed and that the same are true and correct. So help me God.

(Signature) R. L. Shields, pres.  
Shields Bldg., Russell, Kansas  
(Address)

SUBSCRIBED AND SWORN TO before me this 18th day of June, 1974

My commission expires May 26, 1975  
Ruth Phillips  
Notary Public.



# Shields


## WELL LOG

15-163-20518-00-00

Russell, Kansas

Operator: Black Petroleum Co.  
 Well: Schindler #1  
 Commenced: May 24, 1974  
 Completed: May 31, 1974  
 Contractor: Shields Drilling Co., Inc.

Well Description: NE NE SE  
 Sec. 16-8S-17W  
 Rooks Co., Kansas

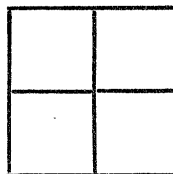

CASING RECORD		
Size	Run	Pulled
8 5/8"	284'	Cmtd. w/150 sax

Elevation:  
 Treatment:  
 Production: D & A

Tops:

..... Figures Indicate Bottom of Formations .....

Top soil, rock, clay & shale	291'
Shale	720'
Sand	815'
Shale	880'
Sand	1,010'
Redbed & shale	1,315'
Anhydrite	1,352'
Shale & shells	1,800'
Shale & lime	2,993'
Lime	3,373'
Lime & conglomerate	3,450' RTD

RECEIVED  
 STATE CORPORATION COMMISSION  
 JUN 25 1974  
 JUN 25 1974  
 CONSERVATION DIVISION  
 Wichita, Kansas

Notes