

STATE OF KANSAS
STATE CORPORATION COMMISSION

WELL PLUGGING RECORD

OR

FORMATION PLUGGING RECORD

Strike out upper line
when reporting plugging
off formations.

Give All Information Completely
Make Required Affidavit
Mail or Deliver Report to:
Conservation Division
State Corporation Commission
800 Bittling Building
Wichita, Kansas

Rooks County, Sec. 10 Twp. 8S Rge. (E) 17 (W)

Location as "NE 1/4 NW 1/4 SW 1/4" or footage from lines Center SW SW SW

Lease Owner The Carter Oil Company

Lease Name Lillie Leist Well No. 1

Office Address P. O. Box 431, Ponca City, Oklahoma

Character of Well (Completed as Oil, Gas or Dry Hole) Dry Hole

Date, well completed April 22 1938

Application for plugging filed April 23 1938

Application for plugging approved April 24 1938

Plugging Commenced April 23 1938


Plugging Completed April 23 1938

Reason for abandonment of well or producing formation

Dry Hole

If a producing well is abandoned, date of last production None 193

Was permission obtained from the Conservation Division or its agents before plugging was commenced? Yes

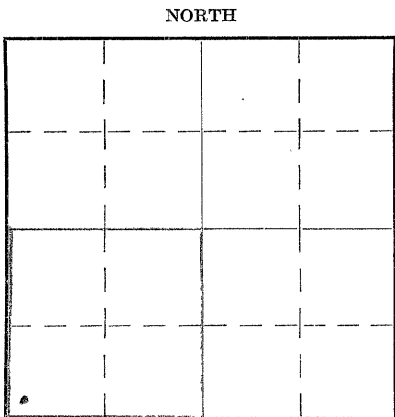

Locate well correctly on above
Section Plat

Name of Conservation Agent who supervised plugging of this well Ed Shiel

Producing formation None Depth to top Bottom Total Depth of Well 3508 Feet.

Show depth and thickness of all water, oil and gas formations.

OIL, GAS OR WATER RECORDS


CASING RECORD

Formation	Content	From	To	Size	Put In	Pulled Out
Arbuckle	Dry	3489'	3508'	8 5/8"	703'	--0--

Describe in detail the manner in which the well was plugged, indicating where the mud fluid was placed and the method or methods used in introducing it into the hole. If cement or other plugs were used, state the character of same and depth placed, from.....feet to.....feet for each plug set.

Set wood plug at 690' in surface pipe and dumped in 10 sacks of
cement. Set wood plug at 35' and dumped in 10 sacks cement.
Filled hole with dirt.

PLUGGING
FILE 10-8-R17W
BOOK PAGE 17 LINE 33

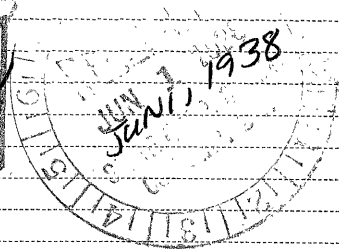

(If additional description is necessary, use BACK of this sheet)

Correspondence regarding this well should be addressed to Mr. W. B. Crutcher
Address P. O. Box 431 - Ponca City, Oklahoma

STATE OF Oklahoma, COUNTY OF Kay, ss.
W. B. Crutcher (employee of owner) or (owner or operator) of the above-described well,

being first duly sworn on oath, says: That I have knowledge of the facts, statements, and matters herein contained and the log of the above-described well as filed and that the same are true and correct. So help me God.

(Signature) W. B. Crutcher

Box 431 - Ponca City, Oklahoma
(Address)

SUBSCRIBED AND SWORN TO before me this 31 day of May, 1938

William J. Richard
Notary Public.

My commission expires 11-22-41