


STATE OF KANSAS
STATE CORPORATION COMMISSION

WELL PLUGGING RECORD

Give All Information Completely
Make Required Affidavit
Mail or Deliver Report to:
Conservation Division
State Corporation Commission
211 No. Broadway
Wichita, Kansas

Rooks County. Sec. 17 Twp. 8 Rge. 17 (E) W (W)
Location as "NE/CNWxSWx" or footage from lines SW SW SW
Lease Owner Murfin Drilling Co.
Lease Name Schindler Well No. 1
Office Address 617 Union Bldg. Wichita, Ks.
Character of Well (completed as Oil, Gas or Dry Hole) Oil
Date well completed _____ 19____
Application for plugging filed _____ May 30, 1962
Application for plugging approved _____ June 4, 1962
Plugging commenced _____ June 1, 1962
Plugging completed _____ June 6, 1962
Reason for abandonment of well or producing formation Oil depleted

NORTH

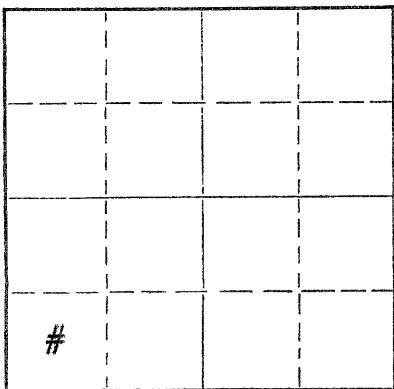

Locate well correctly on above
Section Plat

If a producing well is abandoned, date of last production _____ 19____
Was permission obtained from the Conservation Division or its agents before plugging was commenced? Yes

Name of Conservation Agent who supervised plugging of this well Eldon Petty
Producing formation _____ Depth to top _____ Bottom _____ Total Depth of Well _____ Feet
Show depth and thickness of all water, oil and gas formations.

OIL, GAS OR WATER RECORDS

CASING RECORD

FORMATION	CONTENT	FROM	TO	SIZE	PUT IN	PULLED OUT
				8 5/8	135'	none
				5 1/2	3989	988'

Describe in detail the manner in which the well was plugged, indicating where the mud fluid was placed and the method or methods used in introducing it into the hole. If cement or other plugs were used, state the character of same and depth placed, from _____ feet to _____ feet for each plug set.

Plugged back with sand from 3340' to 3310'. Mixed and dumped 4 sx. cement from 3310' to 3278'. Pulled casing to 550'. Mixed and circulated 20 sx. gel mud and 20 sx. of weight mud. Mixed and pumped in 20 sx. cement from 550' to 490'. Pulled casing to 150'. Mixed and pumped in 20 sx. cement from 150' to 90'. Pulled rest casing. Bailed off gel to 35'. Set 5' rock bridge from 35' to 30'. Mixed and dumped 10 sx. cement from 30' to base cellar.

RECEIVED
STATE CORPORATION COMMISSION
JUL 9 1962
JUL 9 1962
CONSERVATION DIVISION
Wichita, Kansas

(If additional description is necessary, use BACK of this sheet)

Name of Plugging Contractor Ace Pipe Pulling Co.
Address Box 304 Great Bend, Ks.

STATE OF KANSAS COUNTY OF SEDGWICK, ss.
Fred Murfin (employee of owner) or (owner or operator) of the above-described well, being first duly sworn on oath, says: That I have knowledge of the facts, statements, and matters herein contained and the log of the above-described well as filed and that the same are true and correct. So help me God.

(Signature) [Signature]
617 Union Center, Wichita, Kansas
(Address)

SUBSCRIBED AND SWORN TO before me this 5th day of July, 1962

My commission expires 12/18/65

Notary Public.



WELL LOG

COMPANY **Murfin Drilling Company**

SEC. **17** T. **8S** R. **17W**

FARM **Schindler** NO. **1**

LOC. **SW SW SW**

TOTAL DEPTH **3340'**
 COMM. **11-5-58** COMP. **11-13-58 Rotary**
 SHOT OR TREATED
 CONTRACTOR **Murfin Drilling Company**
 ISSUED

COUNTY **Rooks**
 KANSAS

CASING

20	10	
15	8	5/8" @ 189' w/135 sxs.
12	6	
13	5	1/2" @ 3329' w/75 sxs.

ELEVATION **1884' K. B.**
1879' B. L.
 PRODUCTION **23 BOPD**

FIGURES INDICATE BOTTOM OF FORMATIONS

189	Surface Hole
525	Shale - Shells
620	Sand - Shale
700	Shale
760	Sand - Shale
940	Sand
1226	Red Bed - Shells
1263	Anhydrite
1555	Shale - Shells
1650	Salt - Shale
1845	Shale - Lime Shells
3070	Lime - Shale
3130	Lime
3180	Lime - Shale
3270	Lime
3315	Lime - Shale
3325	Arbuckle Lime
3330	Shale - Lime - Sand
3340	Arbuckle Lime

GEOLOGICAL TOPS:

Topeka	2797
Heebner	3010
Toronto	3030
Lansing-Kansas City	3050
Base Kansas City	3276
Marmaton Sand	3284
Simpson Dolomite	3314
Arbuckle	3325

DST #1 3307-21
 Open 30 min. Rec. 5' mud.
 BHP 0#/20 minutes.

DST #2 3320-40
 Open 1 hr. Rec. 10' oil and 30'
 heavily oil cut mud. IF 0#. FF 65#.
 BHP 215#/20 minutes.

RECEIVED
 STATE CORPORATION COMMISSION

JUL 9 1962
 JUL 9, 1962
 CONSERVATION DIVISION
 Wichita, Kansas

State of Kansas }
 County of Sedgwick } ss:

I, W. R. Muffin of the Murfin Drilling Company Company
Schindler #1
 upon oath state that the above and foregoing is a true and correct copy of the log of the _____ well.

W. R. Muffin

Subscribed and sworn to before me this 4th day of February 19 59

My Commission Expires: March 23, 1960

Donna M. Matzek
 NOTARY PUBLIC
Donna M. Matzek