


STATE OF KANSAS  
STATE CORPORATION COMMISSION

WELL PLUGGING RECORD

Give All Information Completely  
Make Required Affidavit  
Mail or Deliver Report to:  
Conservation Division  
State Corporation Commission  
212 No. Market  
Wichita, Kansas

Rooks County, Sec. 12 Twp. 8S Rge. 17 (W)

Location as "NE/CNW/SW" or footage from lines 2310' FNL 990' FWL  
Lease Owner Cities Service Oil Company  
Lease Name Chesney Unit Well No. 101W  
Office Address Box 553 Russell, Kansas  
Character of Well (completed as Oil, Gas or Dry Hole) Injection  
Date well completed May 19 59  
Application for plugging filed 4-9 19 69  
Application for plugging approved 4-10 19 69  
Plugging commenced 4-21 19 69  
Plugging completed 4-21 19 69  
Reason for abandonment of well or producing formation Casing Bad

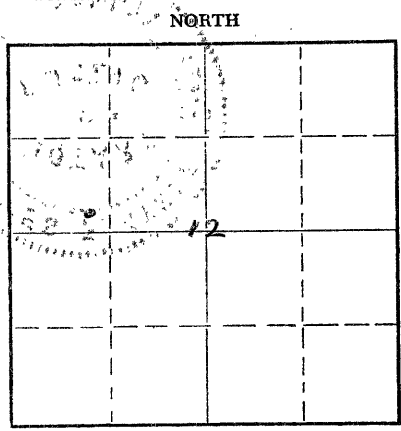

Locate well correctly on above Section Plat

If a producing well is abandoned, date of last production 3-7 19 69  
Was permission obtained from the Conservation Division or its agents before plugging was commenced? Yes

Name of Conservation Agent who supervised plugging of this well Leo Massey Hays, Kansas  
Producing formation Lansing-Kansas City Depth to top 3245' Bottom 3254' Total Depth of Well 3416 Feet  
Show depth and thickness of all water, oil and gas formations.

OIL, GAS OR WATER RECORDS				CASING RECORD		
FORMATION	CONTENT	FROM	TO	SIZE	PUT IN	PULLED OUT
				8 5/8"	239'	None
				5 1/2"	3415'	None

Describe in detail the manner in which the well was plugged, indicating where the mud fluid was placed and the method or methods used in introducing it into the hole. If cement or other plugs were used, state the character of same and depth placed, from feet to feet for each plug set.

Ran 2" tubing to 3034. Top of fish @ 3050' Circulate casing full of mud (32 Sx. Gel + 4 sx. Hulls). Displaced 100 Sx. 50/50 Pozmix and 2% Gel. Cement 3034'-2026'. Pull tubing to 617'. Displaced 15 Sx. 50/50 Pozmix W/2% Gel. Cement 617'-467'. Pull tubing to 216'. Displaced 35 Sx. 50/50 Pozmix W/2% Gel. Cement 216' to surface. Pull tubing. Fill casing W/cement. Job Complete  
2:00 P.M. 4-21-69

RECEIVED  
STATE CORPORATION COMMISSION  
APR 28 1969  
CONSERVATION DIVISION  
Wichita, Kansas

(If additional description is necessary, use BACK of this sheet)


Name of Plugging Contractor Halliburton Co.  
Address Hays, Kansas

STATE OF Kansas, COUNTY OF Russell, ss.  
E. W. Peterman (employee of owner) or (owner or operator) of the above-described well, being first duly sworn on oath, says: That I have knowledge of the facts, statements, and matters herein contained and the log of the above-described well as filed and that the same are true and correct. So help me God.

(Signature) *E. W. Peterman*

Box 553 Russell, Kansas 67665  
(Address)

SUBSCRIBED AND SWORN to before me this 25th day of April, 19 69

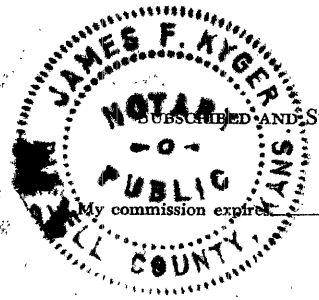

*James F. Kyger*  
Notary Public.