


STATE OF KANSAS
STATE CORPORATION COMMISSION

WELL PLUGGING RECORD

Give All Information Completely
Make Required Affidavit
Mail or Deliver Report to
Conservation Division
State Corporation Comm.
245 North Water
Wichita, KS 67202

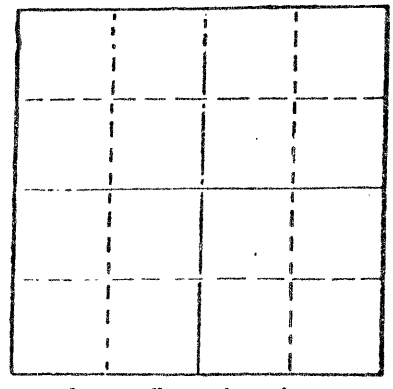

Locate well correctly on above
Section Plat

Rooks County. Sec. 17 Twp. 8s Rge. 17w E/W
Location as "NE/CNW $\frac{1}{4}$ SW $\frac{1}{4}$ " or footage from lines _____
1,000' S. line 330' West line
Lease Owner Lawbanco Drilling, Inc. & M-W-M
Lease Name Schindler Well No. 1
Office Address Box 289 Natoma, Kansas 67651
Character of Well (Completed as Oil, Gas or Dry Hole) _____
dry hole
Date Well completed 9-13-82 19____
Application for plugging filed 9-12-82 19____
Application for plugging approved 9-12-82 19____
Plugging commenced 11:30 P.M. 9-12-82 19____
Plugging completed 1:00 A.M. 9-13-82 19____
Reason for abandonment of well or producing formation _____

If a producing well is abandoned, date of last production _____ 19____

Was permission obtained from the Conservation Division or its agents before plugging was commenced? yes

Name of Conservation Agent who supervised plugging of this well Dennis Hamel
Producing formation _____ Depth to top _____ Bottom _____ Total Depth of Well _____
Show depth and thickness of all water, oil and gas formations.

OIL, GAS OR WATER RECORDS

CASING RECORD

FORMATION	CONTENT	FROM	TO	SIZE	PUT IN	PULLED OUT

Describe in detail the manner in which the well was plugged, indicating where the mud fluid was placed and the method or methods used in introducing it into the hold. If cement or other plugs were used, state the character of same and depth placed, from _____ feet to _____ feet for each plug set.

1st plug 900' with 100 sacks
2nd plug 220' with 40 sacks
3rd plug 40' with 10 sacks with 1/2 sacks hulls & plug for solid bridge
10 sacks for rat hole
Total 160 sacks 50/50 poz 6% gel

RECEIVED
STATE CORPORATION COMMISSION
SEP 29 1982
Sept. 29, 1982
CONSERVATION DIVISION
Wichita, Kansas

(If additional description is necessary, use BACK of this sheet)

Name of Plugging Contractor Lawbanco Drilling, Inc.
Box 289 Natoma, Kansas 67651

STATE OF Kansas COUNTY OF Osborne, ss.
John Weis (employee of owner) or (owner or operator)

of the above-described well, being first duly sworn on oath, says: That I have knowledge of the facts, statements, and matters herein contained and the log of the above-described well as filed and that the same are true and correct. So help me God.

(Signature) John Weis
Countryside Est. 17-B Hays, Ks. 67601
(Address)

SUBSCRIBED AND SWORN TO before me this 27th day of Sept, 1982

My commission expires 10-2-85
Ethel A. John Notary Public.

