

STATE OF KANSAS  
STATE CORPORATION COMMISSION

Form CP-4


Give All Information Completely  
Make Required Affidavit  
Mail or Deliver Report to:  
Conservation Division  
State Corporation Commission  
212 No. Market  
Wichita, Kansas 67202

WELL PLUGGING RECORD

Rooks County, Sec. 18 Twp. 8S Rge. (E) 17 (W)

Location as "NE/CNW/SW" or footage from lines SE SE SW  
Lease Owner Abercrombie Drilling, Inc.  
Lease Name Maddy Well No. 1  
Office Address 801 Union Center, Wichita, Kansas 67202  
Character of Well (completed as Oil, Gas or Dry Hole) Dry Hole  
Date well completed May 15, 1971  
Application for plugging filed (verbally) May 15, 1971  
Application for plugging approved (verbally) May 15, 1971  
Plugging commenced May 15, 1971  
Plugging completed May 15, 1971  
Reason for abandonment of well or producing formation Dry Hole

NORTH

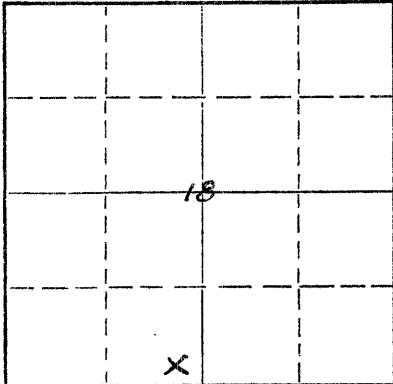

Locate well correctly on above  
Section Plat

If a producing well is abandoned, date of last production 19  
Was permission obtained from the Conservation Division or its agents before plugging was commenced? Yes

Name of Conservation Agent who supervised plugging of this well Leo Massey  
Producing formation \_\_\_\_\_ Depth to top \_\_\_\_\_ Bottom \_\_\_\_\_ Total Depth of Well 3418 Feet  
Show depth and thickness of all water, oil and gas formations.

OIL, GAS OR WATER RECORDS

CASING RECORD

FORMATION	CONTENT	FROM	TO	SIZE	PUT IN	PULLED OUT
				8-5/8"	219'	None

Describe in detail the manner in which the well was plugged, indicating where the mud fluid was placed and the method or methods used in introducing it into the hole. If cement or other plugs were used, state the character of same and depth placed, from \_\_\_\_\_ feet to \_\_\_\_\_ feet for each plug set.

1st plug set at 720' w/40 sx.  
2nd plug set at 210' w/15 sx.  
Top plug set at 40' w/8 sx.  
Job completed at 2:30 p.m. 5-15-71.

RECEIVED  
STATE CORPORATION COMMISSION  
MAY 19 1971 *May 19, 1971*  
CONSERVATION DIVISION  
Wichita, Kansas

(If additional description is necessary, use BACK of this sheet)

Name of Plugging Contractor Abercrombie Drilling, Inc.  
Address 801 Union Center, Wichita, Kansas 67202

STATE OF KANSAS, COUNTY OF SEDGWICK, ss.  
Jack K. Wharton (employee of owner) or (owner or operator) of the above-described

well, being first duly sworn on oath, says: That I have knowledge of the facts, statements, and matters herein contained and the log of the above-described well as filed and that the same are true and correct. So help me God.

(Signature) *Jack K. Wharton*  
801 Union Center, Wichita, Kansas 67202  
(Address)

SUBSCRIBED AND SWORN to before me this 18th day of May, 1971

My commission expires February 20, 1975

*Beverly Mann*  
Beverly Mann, Notary Public.

CONTRACTOR'S WELL LOG

OPERATOR:	Abercrombie Drilling, Inc.
CONTRACTOR:	Abercrombie Drilling, Inc.
WELL NAME:	Maddy #1
LOCATION:	SE SE SW, Sec. 18-8S-17W Rooks County, Kansas
GEOLOGIST:	Jack K. Wharton
SPUD DATE:	May 8, 1971
COMPLETION DATE:	May 15, 1971

0	55	Rock
55	70	Clay & Shale
70	470	Shale
470	675	Sand
675	820	Shale
820	990	Sand
990	1294	Shale
1294	1329	Anhydrite
1329	1685	Shale
1685	1930	Shale & Lime
1930	2965	Lime & Shale
2965	3381	Lime
3381	3418	Lime and Shale
	3418	Rotary Total Depth

Drilled 229' of 12 $\frac{1}{4}$ " surface hole, and set 7-5/8" surface casing at 219' G.L. Cemented w/135 sx. Sunset cement. Cement circulated. Plug was down at 7:00 p.m. 5-8-71. Dry and Abandoned

<u>SAMPLE TOPS</u>	<u>ELEVATION</u>
Anhydrite 1294 (+656)	
B/Anhydrite 1329 (+627)	
Topeka 2873 (-923)	1950 K.B.
Heebner 3082 (-1132)	1948 D.F.
Toronto 3103 (-1153)	1942 G.L.
Lansing 3123 (-1173)	
B/K. C. 3347 (-1397)	
Re-Arbuckle 3407 (-1457)	
Arbuckle 3408 (-1458)	

**RECEIVED**  
 STATE CORPORATION COMMISSION  
 MAY 19 1971  
 CONSERVATION DIVISION  
 Wichita, Kansas

STATE OF KANSAS        )  
                                   ) SS  
 COUNTY OF SEDGWICK    )

Jack K. Wharton, Geologist of Abercrombie Drilling, Inc., does hereby state that the above and foregoing is a true and correct copy of the log of the MADDY #1, SE SE SW, Sec. 18-8S-17W, Rooks County, Kansas.

ABERCROMBIE DRILLING, INC.  
 By: Jack K. Wharton  
 Jack K. Wharton  
 Geologist

Subscribed and sworn to before me, a Notary Public, in and for the aforesaid county and state as of this 18th day of May, 1971.

Beverly Mann  
 Beverly Mann, Notary Public

My Commission Expires:  
 February 10, 1975