


15-163-1722-00-00
01008

STATE OF KANSAS
STATE CORPORATION COMMISSION

Give All Information Completely
Make Required Affidavit
Mail or Deliver Report to:
Conservation Division
State Corporation Commission
211 No. Broadway
Wichita, Kansas

WELL PLUGGING RECORD

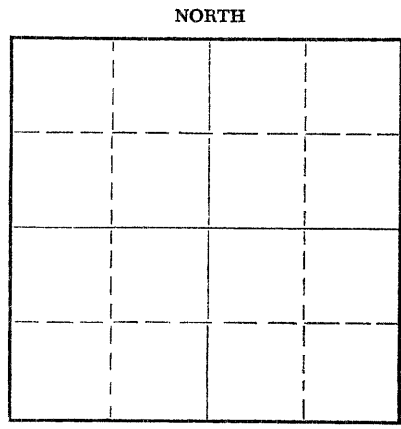

Locate well correctly on above
Section Plat

Rooks County. Sec. 17 Twp. 8 Rge. 17W (E) (W)
Location as "NE/CNW/SW" or footage from lines SW/SW/SW
Lease Owner R. P. Nixon Oil Company
Lease Name Ray Well No. 1
Office Address Russell, Kansas
Character of Well (completed as Oil, Gas or Dry Hole)
Date well completed 19
Application for plugging filed yes 19
Application for plugging approved yes 19
Plugging commenced 9-12-1956
Plugging completed 9-15-1956
Reason for abandonment of well or producing formation

If a producing well is abandoned, date of last production 19
Was permission obtained from the Conservation Division or its agents before plugging was commenced? yes

Name of Conservation Agent who supervised plugging of this well Eldon Petty
Producing formation Depth to top Bottom Total Depth of Well 3355' Feet
Show depth and thickness of all water, oil and gas formations.

OIL, GAS OR WATER RECORDS

CASING RECORD

FORMATION	CONTENT	FROM	TO	SIZE	PUT IN	PULLED OUT
				4 1/2"		1498'

Describe in detail the manner in which the well was plugged, indicating where the mud fluid was placed and the method or methods used in introducing it into the hole. If cement or other plugs were used, state the character of same and depth placed, from feet to feet for each plug set.

Measured into TD 3355'.
Plugging started 9-12-56. Finished 9-15-56.
Plugged off bottom with sand to 3310' and dumped 4 sacks cement with bailer. Shot casing at 1498'. Pulled pipe out of hole, and squeezed 8 5/8" surface casing with 35 sacks aqua-gel mud and 65 sacks cement.

STATE CORPORATION COMMISSION
SEP 21 1956
SEPT 21 ST, 1956
DIVISION

(If additional description is necessary, use BACK of this sheet)
Name of Plugging Contractor J. O. Forbes d/b/a Forbes Casing Pulling Company
Address Box 221, Great Bend, Kansas

STATE OF Kansas, COUNTY OF Barton, ss.
(employee of owner) or (owner or operator) of the above-described well, being first duly sworn on oath, says: That I have knowledge of the facts, statements, and matters herein contained and the log of the above-described well as filed and that the same are true and correct. So help me God.

(Signature) J. O. Forbes
Box 221, Great Bend, Kas.
(Address)

SUBSCRIBED AND SWORN TO before me this 17th day of September, 1956

My commission expires July 11, 1960
Joan Brown Notary Public.

PLUGGING
FILE SEC 17 T 8 R 17W
BOOK PAGE 98 LINE 27