


STATE OF KANSAS
STATE CORPORATION COMMISSION

Give All Information Completely
Make Required Affidavit
Mail or Deliver Report to:
Conservation Division
State Corporation Commission
800 Bitting Building
Wichita, Kansas

WELL PLUGGING RECORD

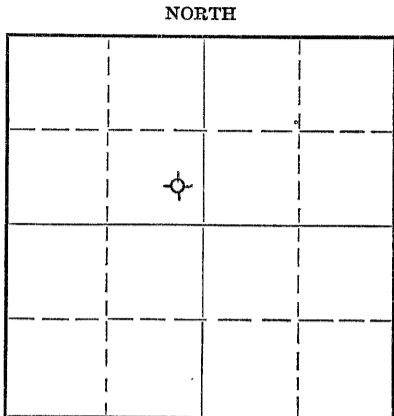

Locate well correctly on above
Section Plat

Rooks _____ County. Sec. 18 Twp. 8 Rge. 17 (E) W. (W)
Location as "NE/CNW $\frac{1}{4}$ SW $\frac{1}{4}$ " or footage from lines SE SE NW
Lease Owner C-G DRILLING CO.
Lease Name MADDY
Office Address 206 Union National Bank Bldg., Wichita, Kansas
Well No. 1
Character of Well (completed as Oil, Gas or Dry Hole) Dry Hole
Date well completed June 29, 19 52
Application for plugging filed June 29, 19 52
Application for plugging approved June 29, 19 52
Plugging commenced June 29, 19 52
Plugging completed June 29, 19 52
Reason for abandonment of well or producing formation too low structurally

If a producing well is abandoned, date of last production -- 19 --
Was permission obtained from the Conservation Division or its agents before plugging was commenced? Yes

Name of Conservation Agent who supervised plugging of this well Eldon Petty, Hays, Kansas
Producing formation --- Depth to top --- Bottom --- Total Depth of Well --- Feet
Show depth and thickness of all water, oil and gas formations.

OIL, GAS OR WATER RECORDS

CASING RECORD

Formation	Content	From	To	Size	Put In	Pulled Out
				8 5/8"	157'	none

Describe in detail the manner in which the well was plugged, indicating where the mud fluid was placed and the method or methods used in introducing it into the hole. If cement or other plugs were used, state the character of same and depth placed, from --- feet to --- feet for each plug set.

Filled hole with mud to 154'; set plug, and 15 sacks cement and 1/2 sack hulls. Filled hole with mud to 40'. Set plug, then filled to top with 10 sacks cement and 1/2 sack hulls.

(If additional description is necessary, use BACK of this sheet)

Name of Plugging Contractor C-G DRILLING CO.
Address 206 Union National Bank Building, Wichita, Kansas.

STATE OF KANSAS, COUNTY OF SEDGWICK, ss.
Vicky Fritz

(employee of owner) or (owner or operator) of the above-described well, being first duly sworn on oath, says: That I have knowledge of the facts, statements, and matters herein contained and the log of the above-described well as filed and that the same are true and correct. So help me God.

(Signature) Vicky Fritz
206 Union National Bank Bldg.,
Wichita, Kansas (Address)

SUBSCRIBED AND SWORN to before me this 1st day of July, 19 52

My commission expires November 21, 1955

Notary Public.

23-8390-s 6-51-20M
FILE SEC 18 8 R 17
BOOK PAGE 27 LINE 25

JUL - 7, 1952
CONSERVATION DIVISION
Wichita, Kansas

CONTRACTOR'S WELL LOG

OPERATOR C-G DRILLING CO. FARM NAME MADDY #1
 LOCATION SE SE NW SEC. 18-8-17W
 POOL NAME _____ COUNTY Rooks STATE Kansas
 COMMENCEMENT DATE June 19, 1952 COMPLETION DATE June 29, 1952

LOG OF WELL

Elevation: 1923 R.B.
 All measurements from the top of rotary bushing.

FROM	TO	FORMATION	DEVIATION FROM VERTICAL	REMARKS
0	157			
157	530	Shale-Shells-Sand		
530	615	Sand		
615	795	Shale-Shells-Sand		
795	1000	Sand		
1000	1065	Red Bed		
1065	1185	Shale-Sand		
1185	1293	Shale		
1293	1330	Anhydrite		
1330	1395	Shale		
1395	1705	Shale	0 - 1500'	
1705	1830	Shale		
1830	1945	Lime-Shale		
1945	2030	Lime-Shale	0 - 2000'	
2030	2110	Lime-Shale		
2110	2185	Lime		
2185	2305	Lime-Shale		
2305	2390	Lime-Shale		
2390	2500	Lime-Shale	0 - 2500'	
2500	2585	Lime-Shale		
2585	2670	Lime-Shale		
2670	2745	Lime-Shale		
2745	2860	Lime-Shale		
2860	2918	Lime-Shale		
2918	2975	Lime-Shale		
2975	3035	Lime-Shale	0 - 3000'	
3035	3100	Lime-Shale		
3100	3140	Lime		
3140	3200	Lime		
3200	3245	Lime		
3245	3290	Lime		
3290	3330	Lime-Shale		
3330	3400	Lime-Shale		
3400	3415	Conglomerate		

JUL-7-1952

CASING LEFT IN HOLE AFTER COMPLETION

Ran 157' (5 jts.) 8 5/8" OD Casing.

STATE OF KANSAS, COUNTY OF SEDGWICK) ss.

The undersigned certifies that to the best of her knowledge and belief, the above facts are true and correct.

C-G DRILLING CO.

By Wickly

Subscribed and sworn to before me this 1st day of July, 1952.

My commission expires: 11/21/55

Marilyn Schmidt
Notary Public

PLUDDING
 FILE SEC 18 T 8 R 17W
 BOOK PAGE 27 LINE 25