

CARD MUST BE TYPED

State of Kansas
NOTICE OF INTENTION TO DRILL
(see rules on reverse side)

CARD MUST BE SIGNED

Starting Date:12.....17.....84.....
month day year 11:00

API Number 15- 059-23, 798-00-00

OPERATOR: License #9607.....

..... N./2. SE. Sec ..33 Twp ..15S, Rge ..20 East
(location) West

NameMax Painter.....

.....2475 Ft North from Southeast Corner of Section

Address9865 Fairwood Lane.....

.....2145 Ft West from Southeast Corner of Section

City/State/ZipMemphis, Tennessee 38119

(Note: Locate well on Section Plat on reverse side)

Contact PersonJim Mietchen.....

Nearest lease or unit boundary line165..... feet.

Phone(913) 242.2700.....

CountyFranklin.....

CONTRACTOR: License #6807.....

Lease Name Faye Matteson Lse #1 Well#2.....

NameOil Drillers & Developers

Domestic well within 330 feet : yes no

City/State 301 Garfield Topeka, KS 66606

Municipal well within one mile : yes no

Well Drilled For:

Well Class:

Type Equipment:

Oil Swd

Oilfield

Mud Rotary

Gas Inj

Pool Ext.

Air Rotary

OWWO Expl

Wildcat

Cable

Depth to Bottom of fresh waternone..... feet

Lowest usable water formation

If OWWO: old well info as follows:

Depth to Bottom of usable water200..... feet

Operator

Surface pipe by Alternate : 1 2

Well Name

Surface pipe to be set20..... feet

Comp Date Old Total Depth

Conductor pipe if any required

Projected Total Depth800..... feet

Ground surface elevation

Projected Formation at TD

This Authorization Expires6-17-85.....

Expected Producing Formations

Approved By12-17-84.....

I certify that we will comply with K.S.A. 55-101, et seq., plus eventually plugging hole to K.C.C. specifications.

Date12/17/84 Signature of Operator or Agent

Reguel Robles

TitleAs. Agent.....

MHC/WOHE 12/17/84


Must be filed with the K.C.C. five (5) days prior to commencing well
 This card void if drilling not started within six (6) months of date received by K.C.C.

CONSERVATION DIVISION

DEC 17 1984

12-17-84

STATE CORPORATION COMMISSION
 A Regular Section of Land
 1 Mile - 5,280 Ft.

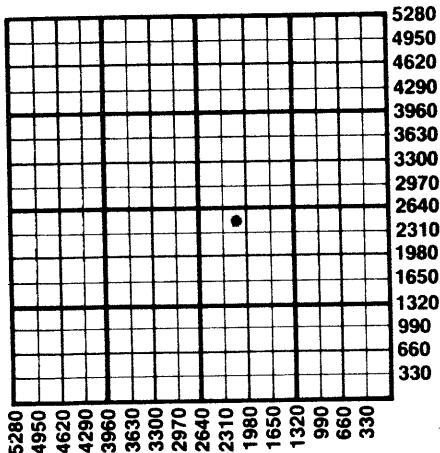

Important procedures to follow :

1. Notify District office before setting surface casing.
2. Set surface casing by circulating cement to the top.
3. File completion forms ACO-1 with K.C.C. within 90 days of well completion, following instructions on ACO-1, side 1, and including copies of wireline logs.
4. Notify District office 48 hours prior to old well workover or re-entry.
5. Prior to plugging, prepare a plugging plan, then obtain agreement from the appropriate district office for an approved plugging plan.
6. Submit plugging report (CP-4) to K.C.C. after plugging is completed.
7. Obtain an approved injection docket number before disposing of salt water.
8. Notify K.C.C. within 10 days when injection commences or terminates.
9. If an alternate 2 completion, cement in the production pipe from below any usable water to surface within 120 days of spud date.

**State Corporation Commission of Kansas
 Conservation Division
 200 Colorado Derby Building
 Wichita, Kansas 67202
 (316)263-3238**