


15-163-01087-00-00

Give All Information Completely
Make Required Affidavit
Mail or Deliver Report to:
Conservation Division
State Corporation Commission
800 Bitting Building
Wichita, Kansas

WELL PLUGGING RECORD

NORTH

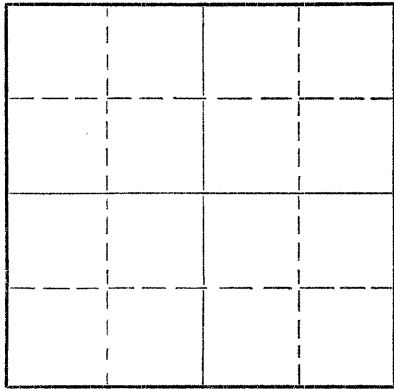

Locate well correctly on above
Section Plat

Rooks _____ County. Sec. 34 Twp. 8 Rge. 17 (X) (W)
Location as "NE/CNW $\frac{1}{4}$ SW $\frac{1}{4}$ " or footage from lines SE SE NE
Lease Owner Rosencrantz-Bemis Drilling Company
Lease Name McMullen Well No. 1
Office Address P. O. Box 713, Great Bend, Kansas
Character of Well (completed as Oil, Gas or Dry Hole) Dry Hole
Date well completed 6-1 19 63
Application for plugging filed 6-1 19 63
Application for plugging approved 6-1 19 63
Plugging commenced 6-1 19 63
Plugging completed 6-1 19 63
Reason for abandonment of well or producing formation Dry Hole

If a producing well is abandoned, date of last production _____ 19____
Was permission obtained from the Conservation Division or its agents before plugging was commenced? Yes

Name of Conservation Agent who supervised plugging of this well Eldon Petty
Producing formation _____ Depth to top _____ Bottom _____ Total Depth of Well 3495 Feet
Show depth and thickness of all water, oil and gas formations.

OIL, GAS OR WATER RECORDS

CASING RECORD

FORMATION	CONTENT	FROM	TO	SIZE	PUT IN	PULLED OUT
Surface Soil past rock & blue shale	Casing	0	200	8 5/8"	200	None

Describe in detail the manner in which the well was plugged, indicating where the mud fluid was placed and the method or methods used in introducing it into the hole. If cement or other plugs were used, state the character of same and depth placed, from _____ feet to _____ feet for each plug set.

PLUGGED: Filled hole with heavy mud from
3495' up to 558' with 1/4 sk. hulls,
20 sacks cement through drill pipe.
Filled hole with mud to 210', 1/4 sk. hulls,
20 sacks cement thru drill pipe.
Filled hole with mud to 40', 1/4 sk.
hulls, 10 sacks cement to cellar Zero.

RECEIVED
STATE CORPORATION COMMISSION

JUN 12 1963

CONSERVATION DIVISION
Wichita, Kan.

6/12/63

(If additional description is necessary, use BACK of this sheet)

Name of Plugging Contractor _____
Address _____

STATE OF KANSAS, COUNTY OF BARTON, ss.
C. J. Netherton-Sec-Tres. (employee of owner) or (owner or operator) of the above-described well, being first duly sworn on oath, says: That I have knowledge of the facts, statements, and matters herein contained and the log of the above-described well as filed and that the same are true and correct. So help me God.

(Signature) C. J. Netherton
P. O. Box 713, Great Bend, Kansas
(Address)

SUBSCRIBED AND SWORN TO before me this 11 day of June 19 63

My commission expires January 2, 1964
Thomas W. Kummer Notary Public.

KS-163-01087-00-00

WELL LOG

Rosencrantz-Bemis Drilling Company-Operator

Rosencrantz-Bemis Drilling Company-Contractor

McMullen #1
SE SE NE
Sec 34-8-17W
Rooks County, Kansas

TD: 3495'

Commenced: 5-23-63
Completed: 6-1-63

Casing:
8 5/8" set @ 200'

Cement:
with 110 sacks

FORMATION:

DEPTH:

Soil and Clay	80
Past Rock	95
Shale	140
Blue Shale	210
Shale	670
Red Bed	690
Shale	890
Sand	1020
Red Bed-Shale	1330
Anhydrite	1370
Shale and Shells	1950
Lime and Shale	3040
Lime	3398
Lime and Shale	3430
Lime	3495

RECEIVED
STATE CORPORATION COMMISSION

JUN 12 1963

CONSERVATION DIVISION
Wichita, Kansas

6/12/63