

CARD MUST BE TYPED

State of Kansas
NOTICE OF INTENTION TO DRILL
(see rules on reverse side)

CARD MUST BE SIGNED

Starting Date: ...7.....19.....85.....
month day year

API Number 15- 163-22,723-00-00

OPERATOR: License # 5635
Name The Gene Brown Co
Address 407 S Main
City/State/Zip Plainville, KS 67663
Contact Person Thomas E Brown
Phone 913-434-4811

East
SW NW Sec 18 Twp 8 S, Rge 17 West
(location)

CONTRACTOR: License # 9087
Name R & C Drilling Co, Inc
City/State Hayes, KS

2970 Ft North from Southeast Corner of Section
4950 Ft West from Southeast Corner of Section
(Note: Locate well on Section Plat on reverse side)

Well Drilled For: **Well Class:** **Type Equipment:**
X Oil Swd X Infield X Mud Rotary
 Gas Inj X Pool Ext. Air Rotary
 OWWO Expl Wildcat Cable

Nearest lease or unit boundary line 350 feet.
County Rooks
Lease Name Maddy A Well# 1
Domestic well within 330 feet: yes no
Municipal well within one mile: yes no

If OWWO: old well info as follows:
Operator
Well Name
Comp Date Old Total Depth
Projected Total Depth 3450 feet
Projected Formation at TD Arbuckle
Expected Producing Formations Arbuckle-Lansing

Depth to Bottom of fresh water 90 feet
Lowest usable water formation Dakota
Depth to Bottom of usable water 800 feet
Surface pipe by Alternate: 1 1/2" 2X
Surface pipe to be set 200 feet
Conductor pipe if any required feet
Ground surface elevation 200 feet MSL
This Authorization Expires 1-16-86
Approved By [Signature] 7-16-85

I certify that we will comply with K.S.A. 55-101, et seq., plus eventually plugging hole to K.C.C. specifications. Production String Will Be Cemented Immediately.

Date 7/16/85 Signature of Operator or Agent [Signature]

Title As Agent Form C-1 4/84


RCR for KOHE

Must be filed with the K.C.C. five (5) days prior to commencing well
 This card void if drilling not started within six (6) months of date received by K.C.C.

RECEIVED
 STATE CORPORATION COMMISSION
 JUL 16 1985
 JUL 16 1985
 CONSERVATION DIVISION
 Wichita, Kansas

Important procedures to follow:

A Regular Section of Land
 1 Mile = 5,280 Ft.

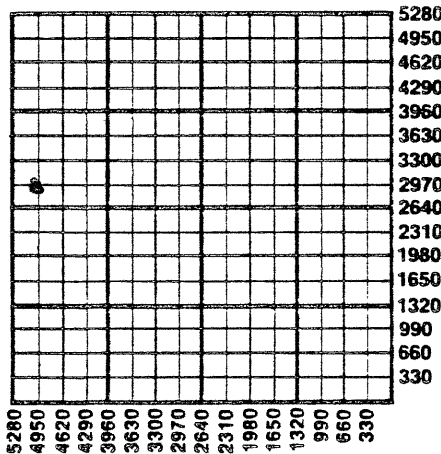

1. Notify District office before setting surface casing.
2. Set surface casing by circulating cement to the top.
3. File completion forms ACO-1 with K.C.C. within 90 days of well completion, following instructions on ACO-1, side 1, and including copies of wireline logs.
4. Notify District office 48 hours prior to old well workover or re-entry.
5. Prior to plugging, prepare a plugging plan, then obtain agreement from the appropriate district office for an approved plugging plan.
6. Submit plugging report (CP-4) to K.C.C. after plugging is completed.
7. Obtain an approved injection docket number before disposing of salt water.
8. Notify K.C.C. within 10 days when injection commences or terminates.
9. If an alternate 2 completion, cement in the production pipe from below any usable water to surface within 120 days of spud date.

State Corporation Commission of Kansas
 Conservation Division
 200 Colorado Derby Building
 Wichita, Kansas 67202
 (316) 263-3238