

CARD MUST BE TYPED

State of Kansas

CARD MUST BE SIGNED

# NOTICE OF INTENTION TO DRILL

(see rules on reverse side)

Starting Date ..... 2 16 87  
month day year

API Number 15— 163-22,913-00-00

OPERATOR: License # 03261

NW. NE. NW. Sec. 18 Twp. 8 S, Rg. 17 X West

Name ..... Petex Corporation

Address ..... 111 Meadows Bldg.

City/State/Zip ..... Dallas, TX 75206

Contact Person ..... H. R. Parkison

Phone ..... 214/363-0101

4950 ..... Ft. from South Line of Section  
3630 ..... Ft. from East Line of Section

(Note: Locate well on Section Plat on reverse side)

CONTRACTOR: License # 5135

Name ..... John O. Farmer, Inc.

City/State ..... Russell, KS 67665

Nearest lease or unit boundary line ..... 330 ..... feet

County ..... Rooks

Lease Name ..... Maddy Well # ..... 1

Ground surface elevation ..... 1951 Est. .... feet MSL

Domestic well within 330 feet: ..... yes X no

Municipal well within one mile: ..... yes X no

Well Drilled For: Well Class: Type Equipment:  
X Oil SWD Infield X Mud Rotary  
Gas Inj Pool Ext Air Rotary  
OWWO Expl Wildcat Cable

Depth to bottom of fresh water ..... 150 ft.

Depth to bottom of usable water ..... 800 ft.

Surface pipe by Alternate: 1 2 X

Surface pipe planned to be set ..... 250 ft.

Conductor pipe required ..... none

Projected Total Depth ..... 3400 ..... feet

Formation ..... Arbuckle

If OWWO: old well info as follows:

Operator .....

Well Name .....

Comp Date ..... Old Total Depth .....

I certify that well will comply with K.S.A. 55-101, et seq., plus eventually plugging hole to KCC specifications.

Date 2/13/87 Signature of Operator or Agent

H. R. Parkison Title: President

For KCC Use:

Conductor Pipe Required ..... feet; Minimum Surface Pipe Required ..... 200 feet per Alt. 4 (2)

This Authorization Expires 8-16-87 Approved By 2-16-87


*[Handwritten signature]*

Must be filed with the K.C.C. five (5) days prior to commencing well  
 This card void if drilling not started within six (6) months of date received by K.C.C.

**Important procedures to follow:**

1. Notify District office before setting surface casing.
2. Set surface casing by circulating cement to the top.
3. File completion forms ACO-1 with K.C.C. within 90 days of well completion, following instructions on ACO-1, side 1, and including copies of wireline logs.
4. Notify District office 48 hours prior to old well workover or re-entry.
5. Prior to filing Intent, prepare a proposed plugging plan in case well is D & A, then obtain approval of plan when calling district office prior to setting surface pipe.
6. Submit plugging report (CP-4) to K. C. C. after plugging is completed.
7. Obtain an approved injection docket number before disposing of salt water.
8. Notify K.C.C. within 10 days when injection commences or terminates.

**A Regular Section of Land**  
**1 Mile = 5,280 Ft.**

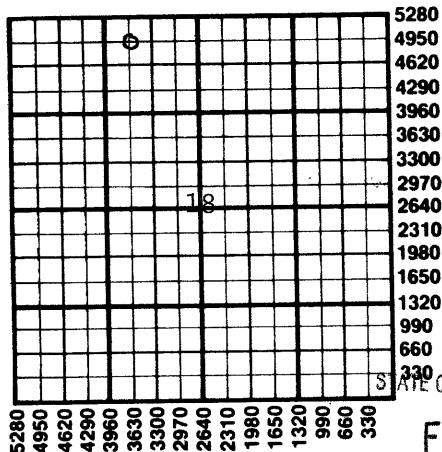

RECEIVED  
 STATE CORPORATION COMMISSION

FEB 16 1987  
 Feb 16, 1987  
 CONSERVATION DIVISION  
 Wichita Kansas

If an alternate 2 completion, cement in the production pipe from below any usable water to surface within 120 days of spud date.

State Corporation Commission of Kansas  
 Conservation Division  
 200 Colorado Derby Building  
 Wichita, Kansas 67202  
 (316) 263-3238