



**IN ALL CASES PLOT THE INTENDED WELL ON THE PLAT BELOW**

*Plat of Acreage attributable to a well in a prorated or spaced field*

**If the intended well is in a prorated or spaced field, please fully complete this side of the form.** If the intended well is in a prorated or spaced field complete the plat below showing that the well will be properly located in relationship to other wells producing from the common source of supply. Please show all the wells and within 1 mile of the boundaries of the proposed acreage attribution unit for gas wells and within 1/2 mile of the boundaries of the proposed acreage attribution unit for oil wells.

API No. 15 - \_\_\_\_\_  
 Operator: LARSON OPERATING COMPANY  
A DIVISION OF LARSON ENGINEERING, INC.  
 Lease: NEIL  
 Well Number: 1-28  
 Field: WILDCAT



Location of Well: County: LANE  
 \_\_\_\_\_  
 \_\_\_\_\_ 910 \_\_\_\_\_ feet from  N /  S Line of Section  
 \_\_\_\_\_ 500 \_\_\_\_\_ feet from  E /  W Line of Section  
 Sec. 28 Twp. 18 S. R. 29  East  West

Number of Acres attributable to well: 40  
 QTR / QTR / QTR of acreage: NE/4 - \_\_\_\_\_ - \_\_\_\_\_

Is Section:  Regular or  Irregular  
**If Section is Irregular, locate well from nearest corner boundary.**  
 Section corner used:  NE  NW  SE  SW

**PLAT**

*(Show location of the well and shade attributable acreage for prorated or spaced wells.)  
 (Show footage to the nearest lease or unit boundary line.)*

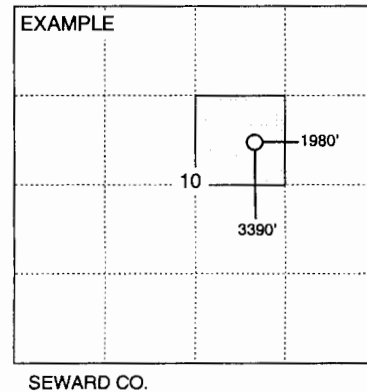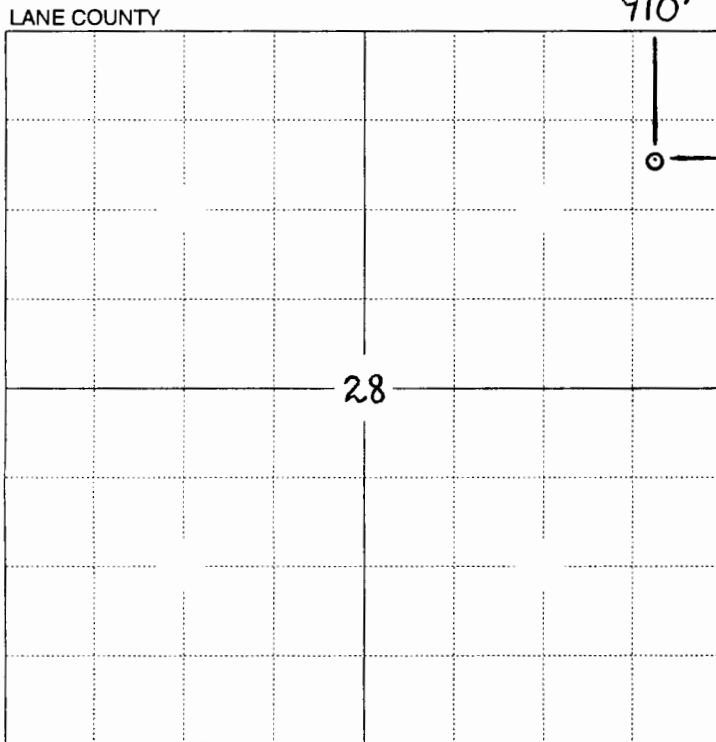

**NOTE: In all cases locate the spot of the proposed drilling location.**

**In plotting the proposed location of the well, you must show:**

1. The manner in which you are using the depicted plat by identifying section lines, i.e. 1 section, 1 section with 8 surrounding sections, 4 sections, etc.
2. The distance of the proposed drilling location from the section's south / north and east / west.
3. The distance to the nearest lease or unit boundary line.
4. If proposed location is located within a prorated or spaced field a certificate of acreage attribution plat must be attached: (CO-7 for oil wells; CG-8 for gas wells).