

Exhibit B
CORRECTED
CARD MUST BE TYPED

CARD MUST BE TYPED
DIST #1 4-5-04
EFFECTIVE DATE 12-21-2005

State of Kansas
NOTICE OF INTENTION TO DRILL
HUGOTON INFILL

564-Ne

Starting Date . . . Expected . . . Feb. . . 15, . . . 2006 . . .
month . . . day . . . year

API Number 15 - 081-21655-00-00

OPERATOR: License # 33538
Name Mayhew Properties
Address P.O. Box 977
City/State/Zip Sublette, KS 67877
Contact Person Chester Mayhew
Phone 620-675-8777

* AP. NW-SE-SE-NE IS SECTION X REGULAR IRREGULAR
Center NE NE Sec. 12 Twp. 30 S. Rg. 34 W
3090 Ft. from South Line of Section
450 Ft. from East Line of Section

CONTRACTOR: License # 33375
Name Cheyenne Drlg. LP
City/State Garden City, KS 67846
Well Drilled as: X New Recompletion OWWO
Projected Total Depth 2900 feet
Formation Hugoton Krider

NOTE: Attach acreage attribution plat locating both Chase (Hugoton) wells
Total number of acres attributed to unit 640

If OWWO or Recompletion: old well info as follows:
Operator
Well Name
Comp. Date Old Total Depth

Nearest producing well from
same common source of supply 2040 feet
Nearest lease or unit boundary line 450 feet
County Haskell
Lease Name MCCOY Well # 2
Ground surface elevation 2980 feet MSL
Depth to bottom of fresh water 750' 680'
Depth to bottom of usable water 750'
Surface pipe by Alternate: 1 X 2
Surface pipe planned to be set 900'
Water Source for Drilled Operations: Mayhew Farm Irrigatio
DWR Permit #: X well farm pond other

I certify that well will comply with K.S.A. 55-101, et seq., plus eventually plugging hole to KCC specifications.
Date 12-21-05 Signature of Operator or Agent Title

For KCC Use:
Conductor Pipe Required NONE feet; Minimum Surface Pipe Required 760' feet per Alt. 1 X
This Authorization Expires 9-30-06 Approved By DPW 3-31-06


RECEIVED
KANSAS CORPORATION COMMISSION
9/95
MAR 15 2006

* DKT # 06-GNS-102-CWLE
* WAS: NE-NE

* IS: APNW-SE-SE-NE

Must be filed with K.C.C. five (5) days prior to commencing well
This card void if drilling not started within six (6) months of date received by K.C.C.

A Regular Section of Land
1 Mile = 5,280 Ft.

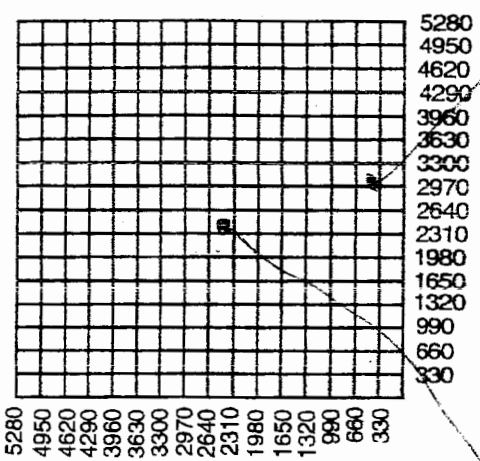

- Important procedures to follow:
1. Notify District office before setting surface casing.
 2. Set surface casing by circulating cement to the top.
 3. File completion forms ACO-1 with K.C.C. within 120 days of well spud date, following instructions on ACO-1, side 1, and including copies of wireline logs.
 4. Notify District office 48 hours prior to old well workover or re-entry.
 5. Submit plugging report (CP-4) to K.C.C. after plugging is completed.
 6. If an alternate 2 completion, cement in the production pipe from below any useable water to surface within 120 days of spud date.

State Corporation Commission of Kansas
Conservation Division
130 S. Market Room 2078
Wichita, Kansas 67202-1212
(316) 337-6231