

CORRECTED

For KCC Use:
Effective Date: 3-5-06
District # 3
SGA? Yes No

KANSAS CORPORATION COMMISSION
OIL & GAS CONSERVATION DIVISION
NOTICE OF INTENT TO DRILL

Form C-1
December 2002
Form must be Typed
Form must be Signed
All blanks must be Filled

Must be approved by KCC five (5) days prior to commencing well

Expected Spud Date 3 02 2006
Spot 5/2 13
SW SW Sec. 46 Twp. 16 S. R. 24

OPERATOR: License# 32294
Name: OSBORN ENERGY, LLC
Address: 24850 FARLEY
City/State/Zip: BUCYRUS, KS 66013
Contact Person: JEFF TAYLOR
Phone: 913-533-9800

CONTRACTOR: License# 5885
Name: R.S. GLAZE DRILLING

Well Drilled For: Oil Gas OWD Seismic
Well Class: Infield Pool Ext Wildcat Other
Type Equipment: Mud Rotary Air Rotary Cable

If OWWO: old well information as follows:
Operator:
Well Name:
Original Completion Date: Original Total Depth:

Directional, Deviated or Horizontal wellbore? Yes No

If Yes, true vertical depth:

Bottom Hole Location:

KCC DKT #:

330 feet from N/S Line of Section
1300 feet from E/W Line of Section

Is SECTION Regular Irregular?

(Note: Locate well on the Section Plat on reverse side)

County: MIAMI

Lease Name: WALKER Well #: 1

Field Name: LOUISBURG

Is this a Prorated / Spaced Field? Yes No

Target Formation(s): MARMATON AND CHEROKEE

Nearest Lease or unit boundary: 650'

Ground Surface Elevation: 1000' feet MSL

Water well within one-quarter mile: Yes No

Public water supply well within one mile: Yes No

Depth to bottom of fresh water: 200+/-

Depth to bottom of usable water: 300+/-

Surface Pipe by Alternate: 1 2

Length of Surface Pipe Planned to be set: 20'

Length of Conductor Pipe required: NONE

Projected Total Depth: 900'

Formation at Total Depth: CHEROKEE

Water Source for Drilling Operations: Well Farm Pond Other X

DWR Permit #:

(Note: Apply for Permit with DWR)

Will Cores be taken? Yes No

If Yes, proposed zone:

WAS: SECTION 16

AFFIDAVIT IS: SECTION 13

The undersigned hereby affirms that the drilling, completion and eventual plugging of this well will comply with K.S.A. 55 et. seq.

It is agreed that the following minimum requirements will be met:

- 1. Notify the appropriate district office prior to spudding of well;
2. A copy of the approved notice of intent to drill shall be posted on each drilling rig;
3. The minimum amount of surface pipe as specified below shall be set by circulating cement to the top;
4. If the well is dry hole, an agreement between the operator and the district office on plug length and placement is necessary prior to plugging;
5. The appropriate district office will be notified before well is either plugged or production casing is cemented in;
6. If an ALTERNATE II COMPLETION, production pipe shall be cemented from below any usable water to surface within 120 days of spud date.

I hereby certify that the statements made herein are true and to the best of my knowledge and belief.

Date: 2/23/06 Signature of Operator or Agent: Title: AGENT

RECEIVED
FEB 27 2006
KCC WICHITA

For KCC Use ONLY
API # 15 - 121-28174-00-00
Conductor pipe required NONE feet
Minimum surface pipe required 20 feet per Alt.
Approved by: DPW 2-28-06/DPW 4-6-06
This authorization expires: 8-28-06
Spud date: Agent:

Remember to:

- File Drill Pit Application (form CDP-1) with Intent to Drill;
- File Completion Form ACO-1 within 120 days of spud date;
- File acreage attribution plat according to field proration orders;
- Notify appropriate district office 48 hours prior to workover or re-entry;
- Submit plugging report (CP-4) after plugging is completed;
- Obtain written approval before disposing or injecting salt water.

Well Not Drilled - Permit Expired
Signature of Operator or Agent:
Date:

Mail to: KCC - Conservation Division, 130 S. Market - Room 2078, Wichita, Kansas 67202

16
14
246

CORRECTED

Side Two

IN ALL CASES PLOT THE INTENDED WELL ON THE PLAT BELOW

Plat of acreage attributable to a well in a prorated or spaced field

If the intended well is in a prorated or spaced field, please fully complete this side of the form. If the intended well is in a prorated or spaced field complete the plat below showing that the well will be properly located in relationship to other wells producing from the common source of supply. Please show all the wells and within 1 mile of the boundaries of the proposed acreage attribution unit for gas wells and within 1/2 mile of the boundaries of the proposed acreage attribution unit for oil wells.

API No. 15 - _____
Operator: OSBORN ENERGY, LLC
Lease: WALKER
Well Number: 1
Field: LOUISBURG

Location of Well: County: MIAMI
330 feet from N / S Line of Section
1300 feet from E / W Line of Section
Sec. ~~10~~ 13 Twp. 16 S. R. 24 East West

Number of Acres attributable to well: _____
QTR / QTR / QTR of acreage: ~~SE~~ ~~SW~~ ~~SW~~

Ap. 20' W. of 5/2 5/2 SW

Is Section: Regular or Irregular

If Section is Irregular, locate well from nearest corner boundary.


Section corner used: NE NW SE SW

*** WAS: SECTION 10 IS: SECTION 13**


PLAT

(Show location of the well and shade attributable acreage for prorated or spaced wells.)

(Show footage to the nearest lease or unit boundary line.)

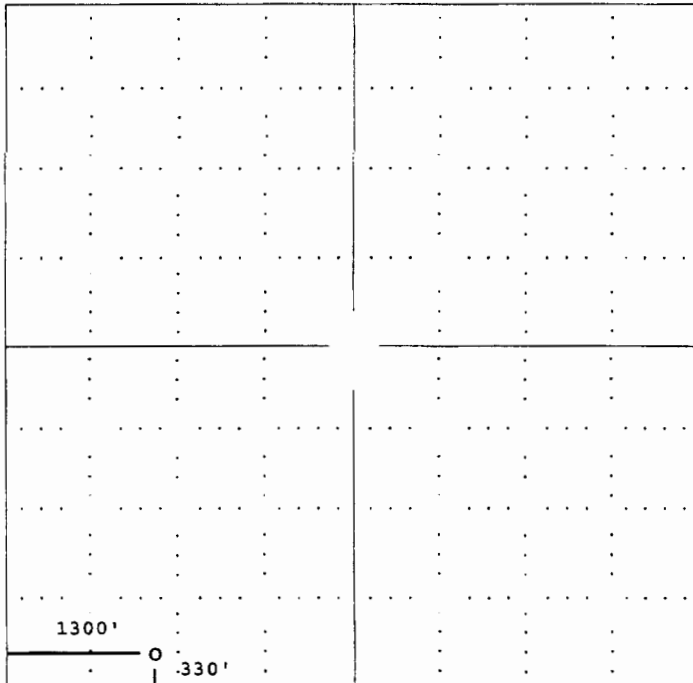

RECEIVED
FEB 27 2008
KCC WICHITA

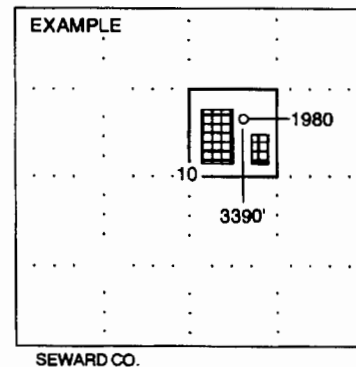

SEWARD CO.

NOTE: In all cases locate the spot of the proposed drilling location.

In plotting the proposed location of the well, you must show:

1. The manner in which you are using the depicted plat by identifying section lines, i.e. 1 section, 1 section with 8 surrounding sections, 4 sections, etc.
2. The distance of the proposed drilling location from the section's south / north and east / west.
3. The distance to the nearest lease or unit boundary line.
4. If proposed location is located within a prorated or spaced field a certificate of acreage attribution plat must be attached: (CO-7 for oil wells; CG-8 for gas wells).