

CARD MUST BE TYPED

State of Kansas

CARD MUST BE SIGNED

NOTICE OF INTENTION TO DRILL

(see rules on reverse side)

Starting Date July 16, 1986
month day year

API Number 15—

059-24,174-00-00

OPERATOR: License # 6807

App. SW SW SW

Sec. 1

Twp. 16

S, Rg. 20

X East

Name Oil Drillers & Developers, Inc.

Address 7929 SW 29th Street

City/State/Zip Topeka, KS 66614

Contact Person Dr. Jerry Fegan

Phone (913) 354-9591, Ext. 388

165 Ft. from South Line of Section

4785 Ft. from East Line of Section

(Note: Locate well on Section Plat on reverse side)

Nearest lease or unit boundary line 165 feet

County Franklin

Lease Name Cathryn Ferguson Well # 7

Ground surface elevation n/a feet MSL

Domestic well within 330 feet: —yes XnoMunicipal well within one mile: —yes Xno

Depth to bottom of fresh water 148

Depth to bottom of usable water 200

Surface pipe by Alternate: 1 — 2 X

Surface pipe planned to be set 40

Conductor pipe required

Projected Total Depth 800 feet

Formation Squirrel

CONTRACTOR: License #

Name Company Tools

City/State

Well Drilled For: Well Class: Type Equipment:

X Oil — SWD X Infield X Mud Rotary

— Gas — Inj — Pool Ext. — Air Rotary

— OWWO — Expl — Wildcat — Cable

If OWWO: old well info as follows:

Operator

Well Name

Comp Date Old Total Depth

I certify that well will comply with K.S.A. 55-101, et seq., plus eventually plugging hole to KCC specifications.

Date 7/16/86 Signature of Operator or Agent Luane Carlson Title As Agent

For KCC Use:

Conductor Pipe Required feet; Minimum Surface Pipe Required 20 feet per Alt. 1-16-87


This Authorization Expires 1-16-87 Approved By 7-16-86

Must be filed with the K.C.C. five (5) days prior to commencing well
This card void if drilling not started within six (6) months of date received by K.C.C.

Important procedures to follow:

1. Notify District office before setting surface casing.
2. Set surface casing by circulating cement to the top.
3. File completion forms ACO-1 with K.C.C. within 90 days of well completion, following instructions on ACO-1, side 1, and including copies of wireline logs.
4. Notify District office 48 hours prior to old well workover or re-entry.
5. Prior to filing Intent, prepare a proposed plugging plan in case well is D & A, then obtain approval of plan when calling district office prior to setting surface pipe.
6. Submit plugging report (CP-4) to K.C.C. after plugging is completed.
7. Obtain an approved injection docket number before disposing of salt water.
8. Notify K.C.C. within 10 days when injection commences or terminates.
9. If an alternate 2 completion, cement in the production pipe from below any usable water to surface within 120 days of spud date.

A Regular Section of Land
1 Mile = 5,280 Ft.

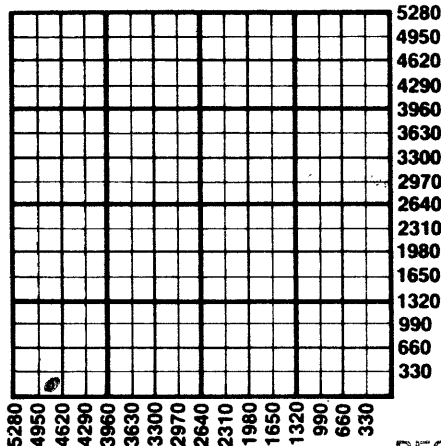

RECEIVED

STATE CORPORATION COMMISSION

JUL 13 1986

CONSERVATION DIVISION

State Corporation Commission of Kansas

Conservation Division

200 Colorado Derby Building

Wichita, Kansas 67202

(316) 263-3238

7-16-86