

CARD MUST BE TYPED

State of Kansas

CARD MUST BE SIGNED

NOTICE OF INTENTION TO DRILL

(see rules on reverse side)

Expected Spud Date..... 06/01/88
month day year

API Number 15— 059-24,344-00-00
NW NW SW XX East

OPERATOR: License # 6807
Name OIL DRILLERS & DEVELOPERS, Inc.

SW SW NW Sec. 1 Twp. 16 S, Rg. 20 West

Address 7929 S.W. 29TH

2580 Ft. from South Line of Section

City/State/Zip TOPEKA 66614

5115 Ft. from East Line of Section

Contact Person JACK SIMPSON

(Note: Locate well on Section Plat on reverse side)

Phone (913) 354-9591

Nearest lease or unit boundary line 165 feet

CONTRACTOR: License # 3417

County FRANKLIN

Name SIMPSON DRILLING

Lease Name EDWARD SEYLER Well # 3

City/State RTE 2 BOX 133 OSOWATAMIKS 66064

Ground surface elevation feet MSL

Well Drilled For: Well Class: Type Equipment:

Domestic well within 330 feet: yes XX no

XX Oil Storage XX Infield XX Mud Rotary

Municipal well within one mile: yes XX no

Gas Inj Pool Ext Air Rotary

Depth to bottom of fresh water 148

OWWO Expil Wildcat Cable

Depth to bottom of usable water KC 200'

If OWWO: old well info as follows:

Surface pipe by Alternate: 1 2XX

Operator

Surface pipe planned to be set 40

Well Name

Conductor pipe required

Comp Date Old Total Depth

Projected Total Depth 900 feet

I certify that well will comply with K.S.A. 55-101, et seq., plus eventually plugging hole to KCC specifications.

Date 06/01/88 Signature of Operator or Agent C. Engler Title AS AGENT

For KCC Use: Conductor Pipe Required feet; Minimum Surface Pipe Required 20 feet per Alt. X (2)

This Authorization Expires 12-1-88 Approved By RCH 6-1-88


EFFECTIVE DATE: 6-6-88

Must be filed with the K.C.C. five (5) days prior to commencing well
 This card void if drilling not started within six (6) months of date received by K.C.C.

Important procedures to follow:

1. Notify District office before setting surface casing.
2. Set surface casing by circulating cement to the top.
3. File completion forms ACO-1 with K.C.C. within 120 days of well spud date, following instructions on ACO-1, side 1, and including copies of wireline logs.
4. Notify District office 48 hours prior to old well workover or re-entry.
5. Prior to filing Intent, prepare a proposed plugging plan in case well is D & A, then obtain approval of plan when calling district office prior to setting surface pipe.
6. Submit plugging report (CP-4) to K.C.C. after plugging is completed.
7. Obtain an approved injection docket number before disposing of salt water.
8. Notify K.C.C. within 10 days when injection commences or terminates.
9. If an alternate 2 completion, cement in the production pipe from below any usable water to surface within 120 days of spud date.

**A Regular Section of Land
 1 Mile = 5,280 Ft.**

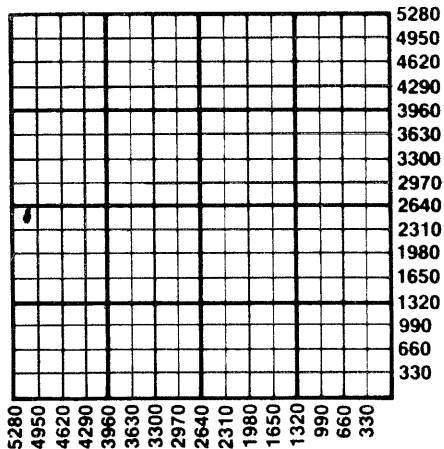

6-1-88

RECEIVED
 STATE CORPORATION COMMISSION
 JUN 1 1988
 CONSERVATION DIVISION
 WICHITA, KANSAS

State Corporation Commission of Kansas
 Conservation Division
 200 Colorado Derby Building
 Wichita, Kansas 67202-1212
 (316) 263-3238