

CARD MUST BE TYPED

State of Kansas

CARD MUST BE SIGNED

NOTICE OF INTENTION TO DRILL

(see rules on reverse side)

(AMENDED INTENT)

Starting Date ..April. 17, 1985.....
month day year

API Number 15— 059-23,889 - ¹⁰⁻⁸⁻⁸⁵ 00-00

OPERATOR: License #5682.....
NameHughes Drilling Company.....
Address122 North Main.....
City/State/ZipWellsville, Kansas. 66092.....
Contact Person.....Roger A. Hughes.....
Phone1-913-883-2235.....

NW SW SE.. Sec. 2... Twp. 16.. S, Rg. 20... X East
f. 1236..... Ft. from South Line of Section
2446..... Ft. from East Line of Section

(Note: Locate well on Section Plat on reverse side)

CONTRACTOR: License #5682.....
NameHughes Drilling Company.....
City/StateWellsville, Kansas.....

Nearest lease or unit boundary line194..... feet
County.....Franklin.....
Lease Name. N. McMillen..... Well #...4.....
Ground surface elevation feet MSL
Domestic well within 330 feet:yes X no
Municipal well within one mile:yes X no
Surface pipe by Alternate: 1 2 X
Depth to bottom of fresh water.....15.....
Depth to bottom of usable water.....200.....
Surface pipe planned to be set20. ft. of 6 1/2".....
Projected Total Depth850..... feet
Formation.....Squirrel.....

Well Drilled For: Well Class: Type Equipment:
X Oil SWD Infield X Mud Rotary
Gas Inj X Pool Ext. Air Rotary
OWWO Expl Wildcat Cable

If OWWO: old well info as follows:

Operator
Well Name
Comp Date Old Total Depth.....

I certify that well will comply with K.S.A. 55-101, et seq., plus eventually plugging hole to KCC specifications. ¹⁰⁻⁸⁻⁸⁵ 1266 PSL

cementing will be done immediately upon setting production casing.

Date ..10/14/85..... Signature of Operator or Agent ..Beatrice E. Hughes..... Title ..Secretary.....

For KCC Use:

Conductor Pipe Required feet; Minimum Surface Pipe Required feet per Alt. 1 2

This Authorization Expires.....10-16-85..... Approved By4-16-85.....

Must be filed with the K.C.C. five (5) days prior to commencing well
This card void if drilling not started within six (6) months of date received by K.C.C.

New Location: 1236' From South line
2446' from East line


Important procedures to follow:

Old location: 1266' from South line
2446' from East line

A Regular Section of Land

1 Mile = 5,280 Ft.

(Old location was too close to NORTH CENTRAL PIPELINE)

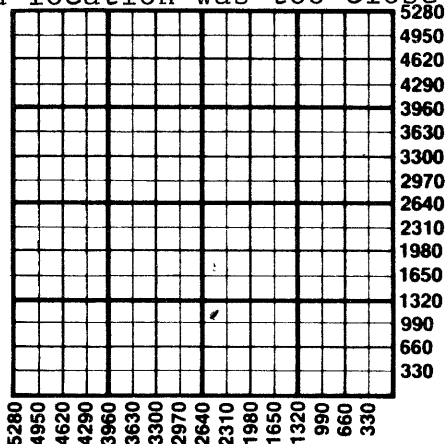

1. Notify District office before setting surface casing.
2. Set surface casing by circulating cement to the top.
3. File completion forms ACO-1 with K.C.C. within 90 days of well completion, following instructions on ACO-1, side 1, and including copies of wireline logs.
4. Notify District office 48 hours prior to old well workover or re-entry.
5. Prior to filing Intent, prepare a proposed plugging plan in case well is D & A, then obtain approval of plan when calling district office prior to setting surface pipe.
6. Submit plugging report (CP-4) to K.C.C. after plugging is completed.
7. Obtain an approved injection docket number before disposing of salt water.
8. Notify K.C.C. within 10 days when injection commences or terminates.

RECEIVED
STATE CORPORATION COMMISSION
If an alternate 2 completion, cement in the production pipe from below any usable water to surface within 120 days of spud date.

State Corporation Commission of Kansas
Conservation Division
200 Colorado Derby Building
Wichita, Kansas 67202
(316) 263-3238

CONSERVATION DIVISION
Wichita, Kansas

10-17-85 OCT 17 1985