

CARD MUST BE TYPED

State of Kansas

CARD MUST BE SIGNED

### NOTICE OF INTENTION TO DRILL

(see rules on reverse side)

Starting Date April 28, 1987  
month day year

API Number 15- 059-24220-00-00

OPERATOR: License # 5682  
Name Hughes Drilling Company  
Address 122 North Main  
City/State/Zip Wellsville, Kansas 66092  
Contact Person Roger A. Hughes  
Phone 913-883-2235

NW SW SE. Sec. 2... Twp. 16. S, Rg. 20...  
1236  
2446  
-X East  
\_\_\_ West  
Ft. from South Line of Section  
Ft. from East Line of Section

(Note: Locate well on Section Plat on reverse side)

CONTRACTOR: License # 5682  
Name Hughes Drilling Company  
City/State Wellsville, Kansas

Nearest lease or unit boundary line 194 feet  
County Franklin  
Lease Name N, McMillen Well # 4  
Ground surface elevation feet MSL

Well Drilled For: Well Class: Type Equipment:  
 Oil \_\_\_ SWD \_\_\_ Infield  Mud Rotary  
\_\_\_ Gas \_\_\_ Inj  Pool Ext. \_\_\_ Air Rotary  
\_\_\_ OWWO \_\_\_ Expl \_\_\_ Wildcat \_\_\_ Cable

Domestic well within 330 feet: \_\_\_yes  no  
Municipal well within one mile: \_\_\_yes  no  
Surface pipe by Alternate: 1 \_\_\_ 2  X  
Depth to bottom of fresh water 15  
Depth to bottom of usable water 200  
Surface pipe planned to be set 20' of 6 1/4"  
Projected Total Depth 850 feet  
Formation Squirrel

If OWWO: old well info as follows:  
Operator  
Well Name  
Comp Date Old Total Depth

I certify that well will comply with K.S.A. 55-101, et seq., plus eventually plugging hole to KCC specifications.

ceementing will be done immediately upon setting production casing.  
Date 4-22-87 Signature of Operator or Agent Beatrice E. [Signature] Title Secretary

For KCC Use:


Conductor Pipe Required feet; Minimum Surface Pipe Required 20 feet per Alt. [Signature]  
This Authorization Expires 10-24-87 Approved By 4-24-87 [Signature]

Must be filed with the K.C.C. five (5) days prior to commencing well  
 This card void if drilling not started within six (6) months of date received by K.C.C.

**Important procedures to follow:**

1. Notify District office before setting surface casing.
2. Set surface casing by circulating cement to the top.
3. File completion forms ACO-1 with K.C.C. within 90 days of well completion, following instructions on ACO-1, side 1, and including copies of wireline logs.
4. Notify District office 48 hours prior to old well workover or re-entry.
5. Prior to filing Intent, prepare a proposed plugging plan in case well is D & A, then obtain approval of plan when calling district office prior to setting surface pipe.
6. Submit plugging report (CP-4) to K.C.C. after plugging is completed.
7. Obtain an approved injection docket number before disposing of salt water.
8. Notify K.C.C. within 10 days when injection commences or terminates.

**A Regular Section of Land**  
**1 Mile = 5,280 Ft.**

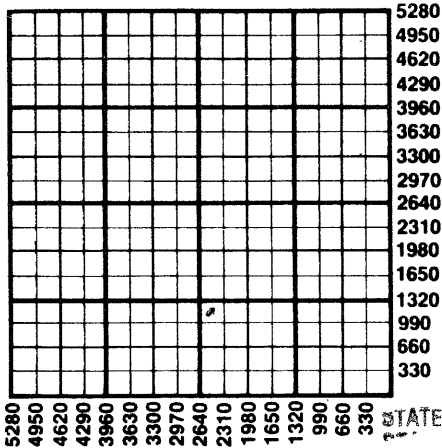

RECEIVED  
 STATE CORPORATION COMMISSION

PR 24 1987

CONSERVATION DIVISION  
 Wichita, Kansas  
 4-24-87

9. If an alternate 2 completion, cement in the production pipe from below any usable water to surface within 120 days of spud date.

State Corporation Commission of Kansas  
 Conservation Division  
 200 Colorado Derby Building  
 Wichita, Kansas 67202  
 (316) 263-3238