

CARD MUST BE TYPED

State of Kansas
NOTICE OF INTENTION TO DRILL
(see rules on reverse side)

CARD MUST BE SIGNED

Starting Date: 7 2 1985
month day year

API Number 15- 059-23,961-00-00

OPERATOR: License # 9873

SW NW SW Sec 3 Twp 16 S, Rge 20 ☒ East
(location) ☐ West

Name Painter Oil Company

Address 9865 Fairwood Lane

City/State/Zip Memphis Tennessee 38119

Contact Person Jerry Hardsaw

Phone (913) 242-5332

CONTRACTOR: License # 6807

1815 Ft North from Southeast Corner of Section
5115 Ft West from Southeast Corner of Section
(Note: Locate well on Section Plat on reverse side)

Name Oil Drillers & Developers

City/State 901 Garfield Topeka, KS 66606

Nearest lease or unit boundary line 165 feet.

County Franklin

Lease Name Vern Stewart Well# 1

Domestic well within 330 feet: ☐ yes ☒ no

Municipal well within one mile: ☐ yes ☒ no

Well Drilled For: Well Class: Type Equipment:

☒ Oil ☐ Swd ☒ Infield ☒ Mud Rotary
☐ Gas ☐ Inj ☐ Pool Ext. ☐ Air Rotary
☐ OWWO ☐ Expl ☐ Wildcat ☐ Cable

Depth to Bottom of fresh water None feet

Lowest usable water formation

Depth to Bottom of usable water 200 feet

Surface pipe by Alternate: 1 ☐ 2 ☒ 40

Surface pipe to be set feet

Conductor pipe if any required feet

Ground surface elevation feet MSL

This Authorization Expires 7-1-85 1-1-86

Approved By Susan Arnold

I certify that we will comply with K.S.A. 55-101, et seq., plus eventually plugging hole to K.C.C. specifications.

Date 7/1/85 Signature of Operator or Agent

Title As Agent


Must be filed with the K.C.C. five (5) days prior to commencing well
This card void if drilling not started within six (6) months of date received by K.C.C.

RECEIVED
STATE CORPORATION COMMISSION

Important procedures to follow:

CONSERVATION DIVISION
Wichita, Kansas

A Regular Section of Land
1 Mile = 5,280 Ft.

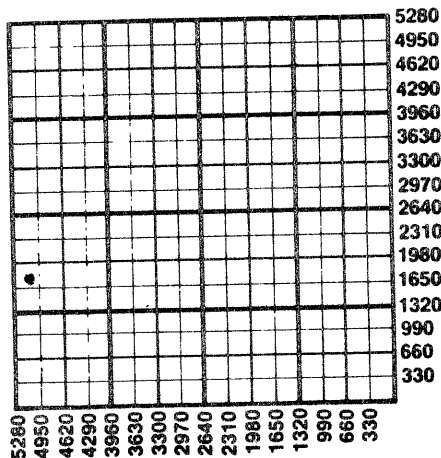

1. Notify District office before setting surface casing.
2. Set surface casing by circulating cement to the top.
3. File completion forms ACO-1 with K.C.C. within 90 days of well completion, following instructions on ACO-1, side 1, and including copies of wireline logs.
4. Notify District office 48 hours prior to old well workover or re-entry.
5. Prior to plugging, prepare a plugging plan, then obtain agreement from the appropriate district office for an approved plugging plan.
6. Submit plugging report (CP-4) to K.C.C. after plugging is completed.
7. Obtain an approved injection docket number before disposing of salt water.
8. Notify K.C.C. within 10 days when injection commences or terminates.
9. If an alternate 2 completion, cement in the production pipe from below any usable water to surface within 120 days of spud date.

State Corporation Commission of Kansas
Conservation Division
200 Colorado Derby Building
Wichita, Kansas 67202
(316) 263-3238