

CARD MUST BE TYPED

State of Kansas

CARD MUST BE SIGNED

NOTICE OF INTENTION TO DRILL

(see rules on reverse side)

Expected Spud Date... Nov. 2, 1987
month day year

API Number 15- 059-24285-00-00

OPERATOR: License # 5682
Name Hughes Drilling Company
Address 122 North Main
City/State/Zip Wellsville, Kansas 66092

NW SW SW Sec...2.. Twp..16. S, Rg...20.. East
795 West
5205 Ft. from South Line of Section
Ft. from East Line of Section

(Note: Locate well on Section Plat on reverse side)

Contact Person... Roger A. Hughes
Phone... 1-913-883-2235

Nearest lease or unit boundary line 795 feet
County... Franklin

CONTRACTOR: License # 5682
Name... Hughes Drilling Company
City/State... Wellsville, Kansas

Lease Name... Wendell Broers... Well #... 9
Ground surface elevation feet MSL

Well Drilled For: Well Class: Type Equipment:
 Oil Storage Infield Mud Rotary
 Gas Inj Pool Ext. Air Rotary
 OWWO Expl Wildcat Cable

Domestic well within 330 feet: yes No
Municipal well within one mile: yes No

If OWWO: old well info as follows:

Depth to bottom of fresh water... 15
Depth to bottom of usable water... 200

Operator
Well Name
Comp Date Old Total Depth.....

Surface pipe by Alternate:
Surface pipe planned to be set... 20 ft. of 6 1/2" 2 X

I certify that well will comply with K.S.A. 55-101, et seq., plus eventually plugging hole to KCC specifications.

Date... 10-27-87 Signature of Operator or Agent

Conductor pipe required
Projected Total Depth... 1000 feet

For KCC Use:

Conductor Pipe Required feet; Minimum Surface Pipe Required

Formation... Bartlesville

This Authorization Expires... 4-30-88

Approved By... R.A. 10-30-87 feet per Alt. 10


EFFECTIVE DATE: 11-4-87

Must be filed with the K.C.C. five (5) days prior to commencing well
 This card void if drilling not started within six (6) months of date received by K.C.C.

Important procedures to follow:

1. Notify District office before setting surface casing.
2. Set surface casing by circulating cement to the top.
3. File completion forms ACO-1 with K.C.C. within 120 days of well spud date, following instructions on ACO-1, side 1, and including copies of wireline logs.
4. Notify District office 48 hours prior to old well workover or re-entry.
5. Prior to filing Intent, prepare a proposed plugging plan in case well is D & A, then obtain approval of plan when calling district office prior to setting surface pipe.
6. Submit plugging report (CP-4) to K.C.C. after plugging is completed.
7. Obtain an approved injection docket number before disposing of salt water.
8. Notify K.C.C. within 10 days when injection commences or terminates.
9. If an alternate 2 completion, cement in the production pipe from below any usable water to surface within 120 days of spud date.

**A Regular Section of Land
 1 Mile = 5,280 Ft.**

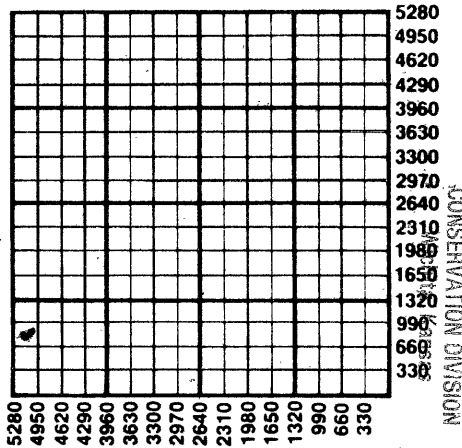

OCT 30 1987

STATE CORPORATION COMMISSION
 RECEIVED

10-30-87

State Corporation Commission of Kansas
 Conservation Division
 200 Colorado Derby Building
 Wichita, Kansas 67202-1212
 (316) 263-3238