

CARD MUST BE TYPED

State of Kansas

CARD MUST BE SIGNED

NOTICE OF INTENTION TO DRILL

(see rules on reverse side)

Expected Spud Date..... 07/12/88
month day year

API Number 15-059-24,355-00-00 *DA*

OPERATOR: License # 6807
Name OIL DRILLERS & DEVELOPERS, Inc
Address 7929 S.W. 29TH
City/State/Zip TOPEKA 66614
Contact Person JERRY FEAGAN
Phone (913) 354-9591

NE SE SW Sec. 36 Twp. 15 S, Rg. 20 XX East West
1000 Ft. from South Line of Section
2970 Ft. from East Line of Section

(Note: Locate well on Section Plat on reverse side)

CONTRACTOR: License # 3417
Name SIMPSON DRILLING
City/State TOPEKA, KANSAS

Nearest lease or unit boundary line 330 feet
County FRANKLIN
Lease Name EDWARD SEYLER 3 Well # 1

Well Drilled For: Well Class: Type Equipment:
XX Oil ___ Storage ___ Infield XX Mud Rotary
___ Gas ___ Inj ___ Pool Ext. ___ Air Rotary
___ OWWO ___ Expl XX Wildcat ___ Cable

Ground surface elevation feet MSL
Domestic well within 330 feet: ___yes XX no
Municipal well within one mile: ___yes XX no

If OWWO: old well info as follows:
Operator
Well Name
Comp Date Old Total Depth.....

Depth to bottom of fresh water
Depth to bottom of usable water *200*
Surface pipe by Alternate: 1 XX
Surface pipe planned to be set 40

I certify that well will comply with K.S.A. 55-101, et seq., plus eventually plugging hole to KCC specifications.
Date 07/06/88 Signature of Operator or Agent *[Signature]* Title AS AGENT

Conductor pipe required
Projected Total Depth 950 feet
Formation BARTLESVILLE

For KCC Use:
Conductor Pipe Required feet; Minimum Surface Pipe Required 20 feet per Alt. *X* (2)
This Authorization Expires 1-6-89 Approved By *R.H. 7-6-88*


EFFECTIVE DATE: 7-11-88

Must be filed with the K.C.C. five (5) days prior to commencing well
This card void if drilling not started within six (6) months of date received by K.C.C.

Important procedures to follow:

1. Notify District office before setting surface casing.
2. Set surface casing by circulating cement to the top.
3. File completion forms ACO-1 with K.C.C. within 120 days of well spud date, following instructions on ACO-1, side 1, and including copies of wireline logs.
4. Notify District office 48 hours prior to old well workover or re-entry.
5. Prior to filing Intent, prepare a proposed plugging plan in case well is D & A, then obtain approval of plan when calling district office prior to setting surface pipe.
6. Submit plugging report (CP-4) to K.C.C. after plugging is completed.
7. Obtain an approved injection docket number before disposing of salt water.
8. Notify K.C.C. within 10 days when injection commences or terminates.
9. If an alternate 2 completion, cement in the production pipe from below any usable water to surface within 120 days of spud date.

A Regular Section of Land
1 Mile = 5,280 Ft.

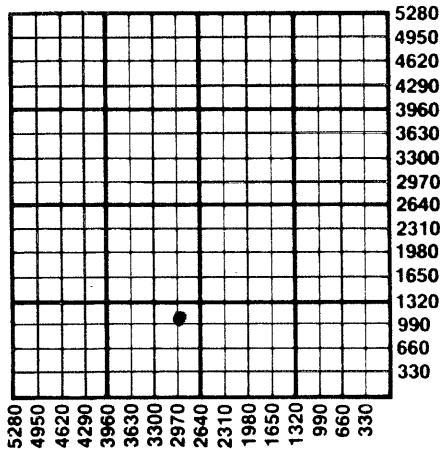

7-6-88

RECEIVED
STATE CORPORATION COMMISSION
STATE CORPORATIO
JUL 11 6 1988

State Corporation Commission of Kansas
CONSERVATION DIVISION
Wichita, Kansas 200 Colorado Derby Building
Wichita, Kansas 67202-1212
(316) 263-3238