

CARD MUST BE TYPED

State of Kansas

CARD MUST BE SIGNED

NOTICE OF INTENTION TO DRILL

(see rules on reverse side)

AMENDED INTENT

9-26-85

Starting Date Sept. 21, 1985
month day year

API Number 15— 059-24,063-00-00

OPERATOR: License # 5682

Name Hughes Drilling Company

Address 122 North Main

City/State/Zip Wellsville, Kansas 66092

Contact Person Roger A. Hughes

Phone 1-913-883-2235

CONTRACTOR: License # 5682

Name Hughes Drilling Company

City/State Wellsville, Kansas 66092

Well Drilled For: Well Class: Type Equipment:

☒ Oil ☐ SWD ☐ Infield ☒ Mud Rotary☐ Gas ☐ Inj ☒ Pool Ext. ☐ Air Rotary☐ OWWO ☐ Expl ☐ Wildcat ☐ Cable

If OWWO: old well info as follows:

Operator

Well Name

Comp Date Old Total Depth

I certify that well will comply with K.S.A. 55-101, et seq., plus eventually plugging hole to KCC specifications.

cementing will be done immediately upon setting production casing.

Date 9-23-85 Signature of Operator or Agent

Title

For KCC Use:

Conductor Pipe Required feet; Minimum Surface Pipe Required feet per Alt. 1 2

This Authorization Expires 3-19-86 Approved By 9-19-85

☒ East

* NW NE NW. Sec. 11. Twp. 16. S, Rg. 20. West

* 5115 Ft. from South Line of Section

* 3605 Ft. from East Line of Section

(Note: Locate well on Section Plat on reverse side)

Nearest lease or unit boundary line 165 feet

County Franklin

Lease Name Lowell Broers Well # 4

Ground surface elevation feet MSL

Domestic well within 330 feet: ☐ yes ☒ noMunicipal well within one mile: ☐ yes ☒ noSurface pipe by Alternate: 1 ☐ 2 ☒

Depth to bottom of fresh water 15

Depth to bottom of usable water 200

Surface pipe planned to be set 20. ft. ... of. 6 1/4"

Projected Total Depth 850 feet

Formation #1 SQUIRREL

* was SE NE NW

4315 FSL

2805 FEL

Must be filed with the K.C.C. five (5) days prior to commencing well

This card void if drilling not started within six (6) months of date received by K.C.C.


New location: 5115' from S line of Section
3605' from E line of Section
NW NE NW

Important procedures to follow:

Old location: 4315' from S line of Section
(SE NE NW) 2805' from E line of Section

A Regular Section of Land

1 Mile = 5,280 Ft.

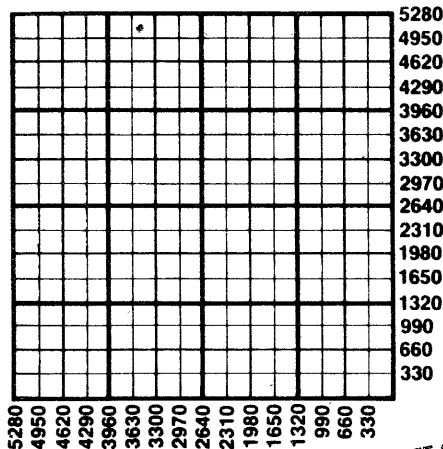

1. Notify District office before setting surface casing.
2. Set surface casing by circulating cement to the top.
3. File completion forms ACO-1 with K.C.C. within 90 days of well completion, following instructions on ACO-1, side 1, and including copies of wireline logs.
4. Notify District office 48 hours prior to old well workover or re-entry.
5. Prior to filing Intent, prepare a proposed plugging plan in case well is D & A, then obtain approval of plan when calling district office prior to setting surface pipe.
6. Submit plugging report (CP-4) to K.C.C. after plugging is completed.
7. Obtain an approved injection docket number before disposing of salt water.
8. Notify K.C.C. within 10 days when injection commences or terminates.
9. If an alternate 2 completion, cement in the production pipe from below any usable water to surface within 120 days of spud date.

RECEIVED
STATE CORPORATION COMMISSION

SEP 26 1985

CONSERVATION DIVISION
Wichita, Kansas

State Corporation Commission of Kansas
Conservation Division
200 Colorado Derby Building
Wichita, Kansas 67202
(316) 263-3238

926-85