

CARD MUST BE TYPED

State of Kansas

CARD MUST BE SIGNED

NOTICE OF INTENTION TO DRILL

(see rules on reverse side)

Starting Date 1 9 87
month day year

OPERATOR: License # 5666

Name Finch's Drilling, Inc.

Address RR #2 Box 125

City/State/Zip Ottawa, KS. 66067

Contact Person Gardner C. Finch

Phone 913-878-3332

CONTRACTOR: License # 5666

Name Company Tools

City/State

Well Drilled For:

Well Class:

Type Equipment:

☒ Oil ☐ SWD ☐ Infield ☒ Mud Rotary☐ Gas ☐ Inj ☐ Pool Ext. ☐ Air Rotary☐ OWWO ☐ Expl ☒ Wildcat ☐ Cable

If OWWO: old well info as follows:

Operator

Well Name

Comp Date Old Total Depth

I certify that well will comply with K.S.A. 55-101, et seq., plus eventually plugging hole to KCC specifications.

cementing will be done immediately upon setting production casing.

Date 1-5-86 Signature of Operator or Agent [Signature] Title [Signature]

For KCC Use:

Conductor Pipe Required feet; Minimum Surface Pipe Required 20 feet per Alt. #2

This Authorization Expires 7-8-87 Approved By 1-8-87 [Signature]

API Number 15- 059-24207-00-00

..... NE SESE Sec. 11 Twp. 16 S, Rg. 20 ☒ East

..... 1000 Ft. from South Line of Section

..... 165 Ft. from East Line of Section

(Note: Locate well on Section Plat on reverse side)

Nearest lease or unit boundary line 165 feet

County Franklin

Lease Name Jacoby Well # 1

Ground surface elevation feet MSL

Domestic well within 330 feet: yes ☒ noMunicipal well within one mile: yes ☒ noSurface pipe by Alternate: 1 ☒ 2 ☒

Depth to bottom of fresh water 200'

Depth to bottom of usable water 200'

Surface pipe planned to be set 21'

Projected Total Depth 800' feet

Formation Squirrel


[Signature]

Must be filed with the K.C.C. five (5) days prior to commencing well
This card void if drilling not started within six (6) months of date received by K.C.C.

Important procedures to follow:

1. Notify District office before setting surface casing.
2. Set surface casing by circulating cement to the top.
3. File completion forms ACO-1 with K.C.C. within 90 days of well completion, following instructions on ACO-1, side 1, and including copies of wireline logs.
4. Notify District office 48 hours prior to old well workover or re-entry.
5. Prior to filing Intent, prepare a proposed plugging plan in case well is D & A, then obtain approval of plan when calling district office prior to setting surface pipe.
6. Submit plugging report (CP-4) to K.C.C. after plugging is completed.
7. Obtain an approved injection docket number before disposing of salt water.
8. Notify K.C.C. within 10 days when injection commences or terminates.

A Regular Section of Land
1 Mile = 5,280 Ft.

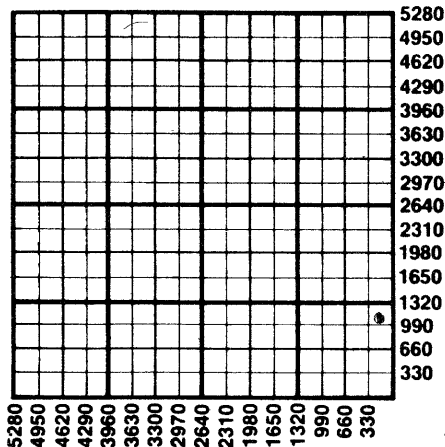

STATE CORPORATION COMMISSION

JAN 8 1987
CONSERVATION DIVISION
Wichita, Kansas

If an alternate 2 completion, cement in the production pipe from below any usable water to surface within 120 days of spud date.

State Corporation Commission of Kansas
Conservation Division
200 Colorado Derby Building
Wichita, Kansas 67202
(316) 263-3238