

CARD MUST BE TYPED

State of Kansas
NOTICE OF INTENTION TO DRILL
 (see rules on reverse side)

CARD MUST BE SIGNED

Starting Date: July 24, 1985
 month day year

API Number 15- 059-24,000-00-00

OPERATOR: License # 5682
 Name Hughes Drilling Company
 Address 122 N. Main
 City/State/Zip Wellsville, Kansas 66092
 Contact Person Roger Hughes
 Phone 913.883.2235

NE SE SW (location) Sec 12 Twp 16 S, Rge 20 ☒ East
☐ West

1315 Ft North from Southeast Corner of Section
 3044 Ft West from Southeast Corner of Section
 (Note: Locate well on Section Plat on reverse side)

CONTRACTOR: License #
 Name Company tools
 City/State

Nearest lease or unit boundary line 404 feet.
 County Franklin
 Lease Name Triple J. Farm Well# 4

Well Drilled For:	Well Class:	Type Equipment:
☒ Oil	☐ Swd	☐ Infield
☐ Gas	☐ Inj	☒ Pool Ext.
☐ OWWO	☐ Expl	☐ Wildcat
		☐ Cable

If OWWO: old well info as follows:

Operator
 Well Name
 Comp Date Old Total Depth
 Projected Total Depth 850 feet
 Projected Formation at TD Squirrel
 Expected Producing Formations

Domestic well within 330 feet: ☐ yes ☒ no
 Municipal well within one mile: ☐ yes ☒ no
 Depth to Bottom of fresh water 100 feet
 Lowest usable water formation
 Depth to Bottom of usable water 500 feet
 Surface pipe by Alternate: 1 ☐ 2 ☒
 Surface pipe to be set 20 feet
 Conductor pipe if any required feet
 Ground surface elevation feet MSL
 This Authorization Expires 1-23-86
 Approved By R.H. 7-23-85

I certify that we will comply with K.S.A. 55-101, et seq., plus eventually plugging hole to K.C.C. specifications.

Date 7/23/85
 Signature of Operator or Agent

Luanne Corless as agent
 Title

Form C-1 4/84

Must be filed with the K.C.C. five (5) days prior to commencing well
This card void if drilling not started within six (6) months of date received by K.C.C.


RECEIVED
STATE CORPORATION COMMISSION

III 23 1985

Important procedures to follow: CONSERVATION DIVISION
Wichita, Kansas

7-23-85

A Regular Section of Land
1 Mile = 5,280 Ft.

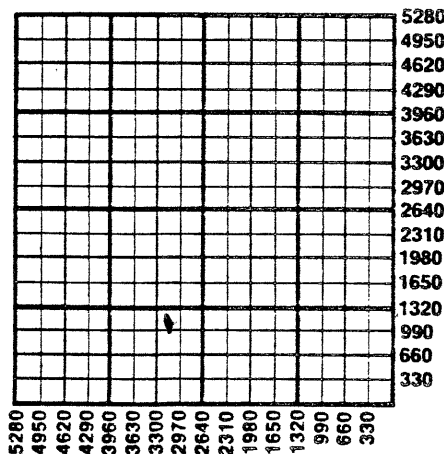

1. Notify District office before setting surface casing.
2. Set surface casing by circulating cement to the top.
3. File completion forms ACO-1 with K.C.C. within 90 days of well completion, following instructions on ACO-1, side 1, and including copies of wireline logs.
4. Notify District office 48 hours prior to old well workover or re-entry.
5. Prior to plugging, prepare a plugging plan, then obtain agreement from the appropriate district office for an approved plugging plan.
6. Submit plugging report (CP-4) to K.C.C. after plugging is completed.
7. Obtain an approved injection docket number before disposing of salt water.
8. Notify K.C.C. within 10 days when injection commences or terminates.
9. If an alternate 2 completion, cement in the production pipe from below any usable water to surface within 120 days of spud date.

State Corporation Commission of Kansas
Conservation Division
200 Colorado Derby Building
Wichita, Kansas 67202
(316) 263-3238