

CARD MUST BE TYPED

State of Kansas

CARD MUST BE SIGNED

NOTICE OF INTENTION TO DRILL

(see rules on reverse side)

Starting Date Oct. 30, 1985
month day yearAPI Number 15— 059-24,082-00-00

OPERATOR: License # 5682
 Name Hughes Drilling Company
 Address 122 North Main
 City/State/Zip Wellsville, Kansas 66092
 Contact Person Roger A. Hughes
 Phone 1-913-883-2235

NE. NE. SW. Sec. 12. Twp. 16 S, Rg. 20... X East
2165..... Ft. from South Line of Section
2970..... Ft. from East Line of Section

(Note: Locate well on Section Plat on reverse side)

CONTRACTOR: License # 5682
 Name Hughes Drilling Company
 City/State Wellsville, Kansas 66092

Nearest lease or unit boundary line 175..... feetCounty..... Franklin.....Lease Name Triple J Farm... Well # .5.....

Ground surface elevation feet MSL

Well Drilled For: Well Class: Type Equipment:
☒ Oil ☐ SWD ☐ Infield ☒ Mud Rotary
☐ Gas ☐ Inj ☒ Pool Ext. ☐ Air Rotary
☐ OWWO ☐ Expl ☐ Wildcat ☐ Cable

Domestic well within 330 feet: ☐ yes ☒ noMunicipal well within one mile: ☐ yes ☒ noSurface pipe by Alternate: 1 2X ☒Depth to bottom of fresh water..... 100.....Depth to bottom of usable water ... 200.....Surface pipe planned to be set ... 20 ft. ... of 6 1/4".....Projected Total Depth 850..... feetFormation... Squirrel.....

If OWWO: old well info as follows:

Operator

Well Name

Comp Date Old Total Depth.....

I certify that well will comply with K.S.A. 55-101, et seq., plus eventually plugging hole to KCC specifications.

_____ cementing will be done immediately upon setting production casing.

Date 10/14/85 Signature of Operator or Agent Beatrice E. Hughes Title Secretary *PCA/KOHE*


For KCC Use:

Conductor Pipe Required feet; Minimum Surface Pipe Required feet per Alt. 2This Authorization Expires 4-17-86 Approved By 10-17-85 *PC*

Must be filed with the K.C.C. five (5) days prior to commencing well
This card void if drilling not started within six (6) months of date received by K.C.C.

Important procedures to follow:

1. Notify District office before setting surface casing.
2. Set surface casing by circulating cement to the top.
3. File completion forms ACO-1 with K.C.C. within 90 days of well completion, following instructions on ACO-1, side 1, and including copies of wireline logs.
4. Notify District office 48 hours prior to old well workover or re-entry.
5. Prior to filing Intent, prepare a proposed plugging plan in case well is D & A, then obtain approval of plan when calling district office prior to setting surface pipe.
6. Submit plugging report (CP-4) to K.C.C. after plugging is completed.
7. Obtain an approved injection docket number before disposing of salt water.
8. Notify K.C.C. within 10 days when injection commences or terminates.

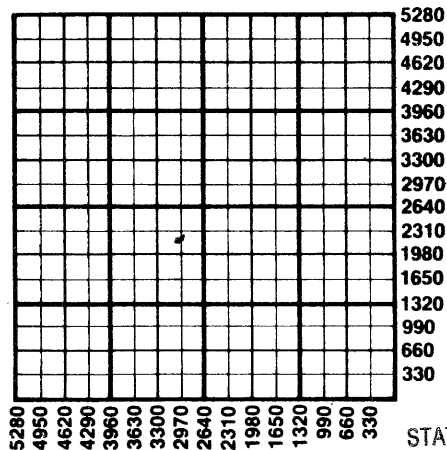

RECEIVED
STATE CORPORATION COMMISSION

OCT 17 1985

CONSERVATION DIVISION
Wichita, Kansas

alternate 2 completion, cement in the production pipe from below any usable water to surface within 120 days of spud date.

State Corporation Commission of Kansas
Conservation Division
200 Colorado Derby Building
Wichita, Kansas 67202
(316) 263-3238

16-17-85