

CARD MUST BE SIGNED

NOTICE OF INTENTION TO DRILL

(see rules on reverse side)

Starting Date ... June 15, .. 1987

API Number 15—

OPERATOR: License #.....5682.....
 Name .. Hughes Drilling Company.....
 Address .. 122 North... Main.....
 City/State/Zip .. Wellsville, Kansas 66092.....
 Contact Person... Roger A. Hughes.....
 Phone... 913-883-2235.....

CONTRACTOR: License # 5682
 Name Hughes Drilling Company
 City/State Wellsville, Kansas 66092

Well Drilled For:		Well Class:	Type Equipment:
☒ Oil	☐ SWD	☐ Infield	☒ Mud Rotary
☐ Gas	☐ Inj	☒ Pool Ext.	☐ Air Rotary
☐ OWWO	☐ Expl	☐ Wildcat	☐ Cable

If OWWO: old well info as follows:

Operator
Well Name
Comp Date..... Old Total Depth.....

I certify that well will comply with K.S.A. 55-101, et seq., plus eventually plugging hole to KCC specifications.

_____ cementing will be done immediately upon setting production casing.

Date 6-10-87... Signature of Operator or Agent Beatrice E. Ship... Title Secretary.....

For KCC Use:

Conductor Pipe Required feet; Minimum Surface Pipe Required 20 feet per Alt. *AB*
This Authorization Expires 12-11-87 Approved By 6-11-87 *K*

X East

SW $\frac{1}{4}$ NW $\frac{1}{4}$ SW $\frac{1}{4}$ Sec. 12.. Twp. 16.. S, Rg. 20.... ~~West~~

2135 Ft. from South Line of Section

5085 Ft. from East Line of Section

(Note: Locate well on Section Plat on reverse side)


Nearest lease or unit boundary line ...195.....feet
County...Franklin.....
Lease Name...Triple J. Farm.... Well #.5A.....
Ground surface elevationfeet MSL
Domestic well within 330 feet: _____yes _____Xno
Municipal well within one mile: _____yes _____Xno
Surface pipe by Alternate: 1____ 2X
Depth to bottom of fresh water.....100.....
Depth to bottom of usable water200.....
Surface pipe planned to be set 20. ft. of 6 1/4".....
Projected Total Depth150.....feet
Formation.....Wyandotte Limestone.....

Must be filed with the K.C.C. five (5) days prior to commencing well
This card void if drilling not started within six (6) months of date received by K.C.C.

Important procedures to follow:

1. Notify District office before setting surface casing.
2. Set surface casing by circulating cement to the top.
3. File completion forms ACO-1 with K.C.C. within 90 days of well completion, following instructions on ACO-1, side 1, and including copies of wireline logs.
4. Notify District office 48 hours prior to old well workover or re-entry.
5. Prior to filing Intent, prepare a proposed plugging plan in case well is D & A, then obtain approval of plan when calling district office prior to setting surface pipe.
6. Submit plugging report (CP-4) to K.C.C. after plugging is completed.
7. Obtain an approved injection docket number before disposing of salt water.
8. Notify K.C.C. within 10 days when injection commences or terminates.
9. If an alternate 2 completion, cement in the production pipe from below any usable water to surface within 120 days of spud date.

A Regular Section of Land
1 Mile = 5,280 Ft.

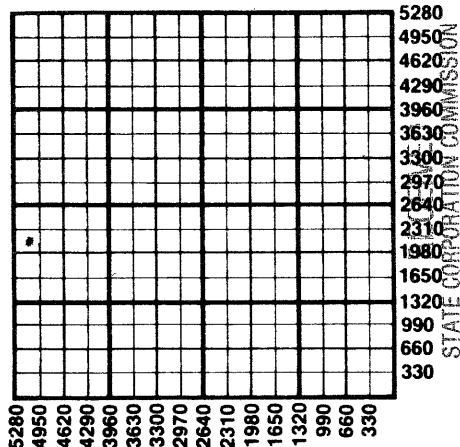

JUN 11 1987

CONSERVATION DIVISION
Wichita, Kansas

State Corporation Commission of Kansas
Conservation Division
200 Colorado Derby Building
Wichita, Kansas 67202
(316) 263-3238