

CARD MUST BE TYPED

State of Kansas

NOTICE OF INTENTION TO DRILL

(see rules on reverse side)

CARD MUST BE SIGNED

CORRECTED LOCATION

Expected Spud Date. 11 18 1987
month day year

API Number 15- 15-059-24,290-1000
16-00-1000 East

OPERATOR: License # 9992

\* SW NW NW Sec 12 Twp 16 S, Rg 20 West

Name J. & C. Oil Company

Address RR #1 Box G-14

City/State/Zip Wellsville, Kansas 66092

Contact Person Jim Hoehn

Phone (913) 883-4268

\* 4290 Ft. from South Line of Section

\* 4950 Ft. from East Line of Section

CONTRACTOR: License # 3550

(Note: Locate well on Section Plat on reverse side)

\* Nearest lease or unit boundary line 330 feet

Name Central Plains Drilling

City/State Ottawa, Kansas 66067

County FRANKLIN

Lease Name DeBRABANDER Well # 1

Ground surface elevation feet MSL

Domestic well within 330 feet: yes no

Municipal well within one mile: yes no

Depth to bottom of fresh water 0

Depth to bottom of usable water 200

Surface pipe by Alternate: 1 2 X

Surface pipe planned to be set 20

Conductor pipe required None

Projected Total Depth 700 feet

Formation

\* Well Drilled For: Well Class: Type Equipment:
X Oil Storage Infield Mud Rotary
X Gas Inj Pool Ext X Air Rotary
OWWO Expl X Wildcat Cable

If OWWO: old well info as follows:

Operator

Well Name

Comp Date Old Total Depth

I certify that well will comply with K.S.A. 55-101, et seq., plus eventually plugging hole to KCC specifications.

Date 11-13-87 Signature of Operator or Agent Title Agent

For KCC Use:

Conductor Pipe Required feet; Minimum Surface Pipe Required 20 feet per Alt. A2

This Authorization Expires 5-13-88 Approved By Ret. 11-13-87 12-7-87


LOCATION WAS 4455 FSL 5115 FEL NLL 165'

Must be filed with the K.C.C. five (5) days prior to commencing well  
 This card void if drilling not started within six (6) months of date received by K.C.C.

**Important procedures to follow:**

1. Notify District office before setting surface casing.
2. Set surface casing by circulating cement to the top.
3. File completion forms ACO-1 with K.C.C. within 120 days of well spud date, following instructions on ACO-1, side 1, and including copies of wireline logs.
4. Notify District office 48 hours prior to old well workover or re-entry.
5. Prior to filing Intent, prepare a proposed plugging plan in case well is D & A, then obtain approval of plan when calling district office prior to setting surface pipe.
6. Submit plugging report (CP-4) to K.C.C. after plugging is completed.
7. Obtain an approved injection docket number before disposing of salt water.
8. Notify K.C.C. within 10 days when injection commences or terminates.
9. If an alternate 2 completion, cement in the production pipe from below any usable water to surface within 120 days of spud date.

**A Regular Section of Land**  
**1 Mile = 5,280 Ft.**

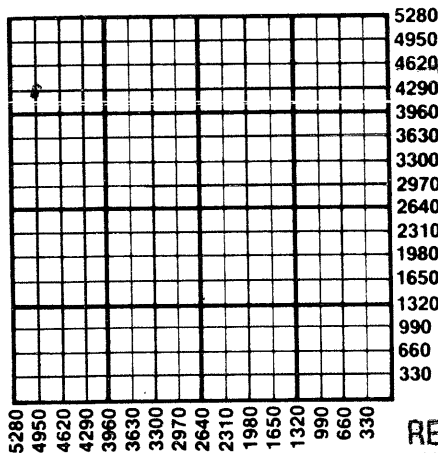

RECEIVED  
 STATE CORPORATION COMMISSION

12-7-87  
 DEC 7 1987

CONSERVATION DIVISION  
 Wichita, Kansas

State Corporation Commission of Kansas  
 Conservation Division  
 200 Colorado Derby Building  
 Wichita, Kansas 67202-1212  
 (316) 263-3238