CARD MUST BE TYPED

State of Kansas

NOTICE OF INTENTION TO DRILL

(see rules on reverse side)

CARD MUST BE SIGNED

Expected Spud Date: Jan. 11, 1988 (month / day / year)

API Number 15— 059-24,300-00-00

OPERATOR: License # 5682

Name: Hughes Drilling Company

Address: 122 North Main

City/State/Zip: Wellsville, Kansas 66092

Contact Person: roger A. Hughes

Phone: 1-913-883-2235

CONTRACTOR: License # 5682

Name: Hughes Drilling Company

City/State: Wellsville, Kansas 66092

SE SE NE Sec. 12 Twp. 16 S, Rg. 20 — X East / ___ West

3205 Ft. from South Line of Section

565 Ft. from East Line of Section

(Note: Locate well on Section Plat on reverse side)

Nearest lease or unit boundary line 565 feet

County: Franklin

Lease Name: Triple J East Well # 4

Ground surface elevation ..... feet MSL

Domestic well within 330 feet: ___ yes X no

Municipal well within one mile: ___ yes X no

Depth to bottom of fresh water: 100

Depth to bottom of usable water: 200

Surface pipe by Alternate: 1 ___ 2 X

Surface pipe planned to be set: 20 ft. of 6¼"

Conductor pipe required .....

Projected Total Depth: 800 feet

Formation: Squirrel Sandstone

Well Drilled For:		Well Class:	Type Equipment:
X Oil	___ Storage	___ Infield	X Mud Rotary
___ Gas	___ Inj	X Pool Ext.	___ Air Rotary
___ OWWO	___ Expl	___ Wildcat	___ Cable

If OWWO: old well info as follows:

Operator .....

Well Name .....

Comp Date ..... Old Total Depth .....

I certify that well will comply with K.S.A. 55-101, et seq., plus eventually plugging hole to KCC specifications.

Date 1-4-88 Signature of Operator or Agent Beatrice E. Hughes Title Secretary

For KCC Use:


Conductor Pipe Required ..... feet; Minimum Surface Pipe Required 20 feet per Alt. X (2)

This Authorization Expires 7-6-88 Approved By RCH 1-6-88

EFFECTIVE DATE: 1-11-88

Must be filed with the K.C.C. five (5) days prior to commencing well
This card void if drilling not started within six (6) months of date received by K.C.C.

A Regular Section of Land
1 Mile = 5,280 Ft.

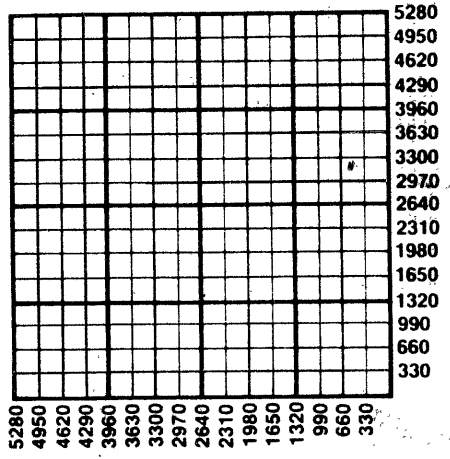

Important procedures to follow:

1. Notify District office before setting surface casing.
2. Set surface casing by circulating cement to the top.
3. File completion forms ACO-1 with K.C.C. within 120 days of well spud date, following instructions on ACO-1, side 1, and including copies of wireline logs.
4. Notify District office 48 hours prior to old well workover or re-entry.
5. Prior to filing Intent, prepare a proposed plugging plan in case well is D & A, then obtain approval of plan when calling district office prior to setting surface pipe.
6. Submit plugging report (CP-4) to K.C.C. after plugging is completed.
7. Obtain an approved injection docket number before disposing of salt water.
8. Notify K.C.C. within 10 days when injection commences or terminates.
9. If an alternate 2 completion, cement in the production pipe from below any usable water to surface within 120 days of spud date.

06 1988
1-6-88

State Corporation Commission of Kansas
Conservation Division
200 Colorado Derby Building
Wichita, Kansas 67202-1212
(316) 263-3238