

CARD MUST BE TYPED

State of Kansas

CARD MUST BE SIGNED

### NOTICE OF INTENTION TO DRILL

(see rules on reverse side)

Expected Spud Date..... 03/14/88  
month day year

API Number 15—059-24,318-00-00 ✓

OPERATOR: License # 9873

Sec. 3 Twp. 16 S, Rg. 20 XX East

NW NE NW 4950 Ft. from South Line of Section

3865 Ft. from East Line of Section

(Note: Locate well on Section Plat on reverse side)

Nearest lease or unit boundary line 330 feet

County Franklin

Lease Name Lester Scott Well # 3

Ground surface elevation feet MSL

Domestic well within 330 feet: \_\_\_yes XX no

Municipal well within one mile: \_\_\_yes XX no

Depth to bottom of fresh water.....

Depth to bottom of usable water 200

Surface pipe by Alternate: 1 \_\_\_ 2 XX

Surface pipe planned to be set 40

Conductor pipe required

Projected Total Depth 950 feet

Formation Bartlesville

Name Painter Oil Company

Address P.O. Box 141B Rt 2

City/State/Zip Wellsville, Kansas 66092

Contact Person Max Painter

Phone (901) 685-7121

CONTRACTOR: License # 3417

Name Simpson Drilling

City/State Osawatomie, Kansas 66064

Well Drilled For: Well Class: Type Equipment:

XX Oil \_\_\_ Storage \_\_\_ Infield XX Mud Rotary

\_\_\_ Gas \_\_\_ Inj \_\_\_ Pool Ext. \_\_\_ Air Rotary

\_\_\_ OWWO \_\_\_ Expl XX Wildcat \_\_\_ Cable

If OWWO: old well info as follows:

Operator

Well Name

Comp Date Old Total Depth

I certify that well will comply with K.S.A. 55-101, et seq., plus eventually plugging hole to KCC specifications.

Date 03/10/88 Signature of Operator or Agent Carol Engstrom

Title A.S. Agent

For KCC Use:

Conductor Pipe Required feet; Minimum Surface Pipe Required

This Authorization Expires 9-10-88


20 feet per Alt. XX 2

Approved By 7-14-3-10-88

EFFECTIVE DATE: 3-15-88

Must be filed with the K.C.C. five (5) days prior to commencing well  
This card void if drilling not started within six (6) months of date received by K.C.C.

A Regular Section of Land  
1 Mile = 5,280 Ft.

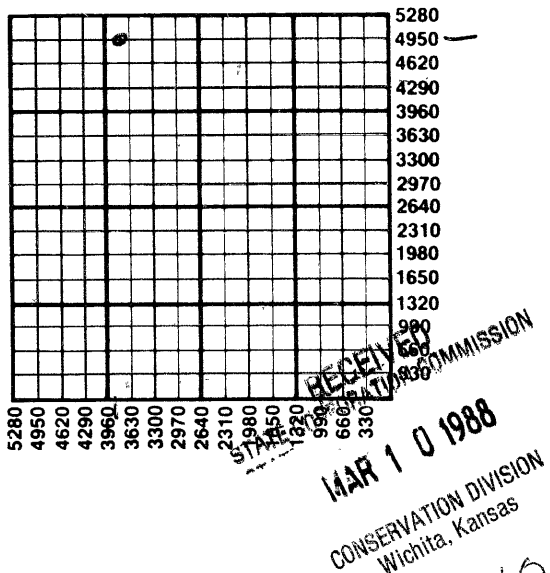

Important procedures to follow:

1. Notify District office before setting surface casing.
2. Set surface casing by circulating cement to the top.
3. File completion forms ACO-1 with K.C.C. within 120 days of well spud date, following instructions on ACO-1, side 1, and including copies of wireline logs.
4. Notify District office 48 hours prior to old well workover or re-entry.
5. Prior to filing Intent, prepare a proposed plugging plan in case well is D & A, then obtain approval of plan when calling district office prior to setting surface pipe.
6. Submit plugging report (CP-4) to K.C.C. after plugging is completed.
7. Obtain an approved injection docket number before disposing of salt water.
8. Notify K.C.C. within 10 days when injection commences or terminates.
9. If an alternate 2 completion, cement in the production pipe from below any usable water to surface within 120 days of spud date.

State Corporation Commission of Kansas  
Conservation Division  
200 Colorado Derby Building  
Wichita, Kansas 67202-1212  
(316) 263-3238