

CARD MUST BE TYPED

State of Kansas

CARD MUST BE SIGNED

NOTICE OF INTENTION TO DRILL

(see rules on reverse side)

Expected Spud Date..... 04/05/88.....
month day year

API Number 15-059-24,327-00-00 ✓ 0

OPERATOR: License #..... 9873.....
Name..... PAINTER OIL COMPANY.....
Address..... P.O. BOX 141R, RT. 2.....
City/State/Zip..... WELLSVILLE..... 66092.....
Contact Person..... MAX PAINTER.....
Phone..... (901) 685-7121.....

E/2 NE NW Sec 3..... Twp 16.... S, Rg 20.....
..... 4620..... Ft. from South Line of Section
..... 3185..... Ft. from East Line of Section

(Note: Locate well on Section Plat on reverse side)

CONTRACTOR: License # 417.....
Name..... Simpson Drilling.....
City/State..... Osawatomie, Kansas..... 66064.....

Nearest lease or unit boundary line 330..... feet
County..... Franklin.....
Lease Name..... Jester Scott..... Well #..... 7.....

Well Drilled For: Well Class: Type Equipment:
XX Oil _____ Storage XX Infield XX Mud Rotary
_____ Gas _____ Inj _____ Pool Ext. _____ Air Rotary
_____ OWWO _____ Expl _____ Wildcat _____ Cable

Ground surface elevation feet MSL
Domestic well within 330 feet: _____ yes XX _____ no
Municipal well within one mile: _____ yes XX _____ no

If OWWO: old well info as follows:

Operator
Well Name
Comp Date..... Old Total Depth.....

Depth to bottom of fresh water.....
Depth to bottom of usable water 200.....
Surface pipe by Alternate: 1-XX-
Surface pipe planned to be set 20.....

I certify that well will comply with K.S.A. 55-101, et seq., plus eventually plugging hole to KCC specifications.

Date 4/01/88..... Signature of Operator or Agent

Greg Engleman Title Agent

For KCC Use:

Conductor Pipe Required feet; Minimum Surface Pipe Required 20 feet per Alt. X 2
This Authorization Expires 10-1-88 Approved By RCH 4-1-88


EFFECTIVE DATE: 4-6-88

Must be filed with the K.C.C. five (5) days prior to commencing well
 This card void if drilling not started within six (6) months of date received by K.C.C.

Important procedures to follow:

1. Notify District office before setting surface casing.
2. Set surface casing by circulating cement to the top.
3. File completion forms ACO-1 with K.C.C. within 120 days of well spud date, following instructions on ACO-1, side 1, and including copies of wireline logs.
4. Notify District office 48 hours prior to old well workover or re-entry.
5. Prior to filing Intent, prepare a proposed plugging plan in case well is D & A, then obtain approval of plan when calling district office prior to setting surface pipe.
6. Submit plugging report (CP-4) to K.C.C. after plugging is completed.
7. Obtain an approved injection docket number before disposing of salt water.
8. Notify K.C.C. within 10 days when injection commences or terminates.
9. If an alternate 2 completion, cement in the production pipe from below any usable water to surface within 120 days of spud date.

A Regular Section of Land
1 Mile = 5,280 Ft.

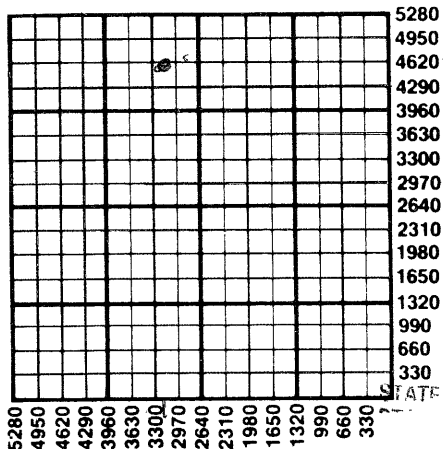

RECEIVED

STATE CORPORATION COMMISSION

4PR 1 1988

Wichita, Kansas
 24-1-88

State Corporation Commission of Kansas
 Conservation Division
 200 Colorado Derby Building
 Wichita, Kansas 67202-1212
 (316) 263-3238