

CARD MUST BE TYPED

State of Kansas

CARD MUST BE SIGNED

NOTICE OF INTENTION TO DRILL

(see rules on reverse side)

Expected Spud Date..... 11/04/88
month day year

API Number 15- 059-24,393-00-00 ^{XX} East

OPERATOR: License #..... 9873

APP NW NW Sec... 03 Twp... 16 S, Rg... 20 West

Name..... PAINTER OIL COMPANY

Address..... P.O. BOX 141B, RT 2

City/State/Zip..... WELLSVILLE 66092

Contact Person..... MAX PAINTER

Phone..... (901) 685-7121

..... 4620 Ft. from South Line of Section

..... 4195 Ft. from East Line of Section

(Note: Locate well on Section Plat on reverse side)

Nearest lease or unit boundary line 660 feet

County..... FRANKLIN

Lease Name..... LESTER SCOTT Well #..... 8

Ground surface elevation APX 900 feet MSL

Domestic well within 330 feet: _____ yes XX no

Municipal well within one mile: _____ yes XX no

Depth to bottom of fresh water... 100

Depth to bottom of usable water... 200

Surface pipe by Alternate: 1 _____ 2 XX

Surface pipe planned to be set 40

Conductor pipe required *****

Projected Total Depth 760 feet

Formation..... SQUIRREL

CONTRACTOR: License #..... 3417

Name..... SIMPSON DRILLING

City/State..... OSAWATOMIE 66064

Well Drilled For: Well Class: Type Equipment:

___ Oil ___ Storage XX Infield XX Mud Rotary

___ Gas XX nj ___ Pool Ext. ___ Air Rotary

___ OWWO ___ Expl ___ Wildcat ___ Cable

If OWWO: old well info as follows:

Operator

Well Name

Comp Date..... Old Total Depth.....

I certify that well will comply with K.S.A. 55-101, et seq., plus eventually plugging hole to KCC specifications.

Date .. 11/04/88 .. Signature of Operator or Agent [Signature] Title. AS AGENT

For KCC Use:

Conductor Pipe Required feet; Minimum Surface Pipe Required 20' feet per Alt. (2)

This Authorization Expires..... 5-1-89 Approved By [Signature] 11-4-88


EFFECTIVE DATE: 11-9-88

Must be filed with the K.C.C. five (5) days prior to commencing well
 This card void if drilling not started within six (6) months of date received by K.C.C.

Important procedures to follow:

1. Notify District office before setting surface casing.
2. Set surface casing by circulating cement to the top.
3. File completion forms ACO-1 with K.C.C. within 120 days of well spud date, following instructions on ACO-1, side I, and including copies of wireline logs.
4. Notify District office 48 hours prior to old well workover or re-entry.
5. Prior to filing Intent, prepare a proposed plugging plan in case well is D & A, then obtain approval of plan when calling district office prior to setting surface pipe.
6. Submit plugging report (CP-4) to K.C.C. after plugging is completed.
7. Obtain an approved injection docket number before disposing of salt water.
8. Notify K.C.C. within 10 days when injection commences or terminates.
9. If an alternate completion, cement in the production pipe from below any usable water to surface within 120 days of spud date.

A Regular Section of Land
1 Mile = 5,280 Ft.

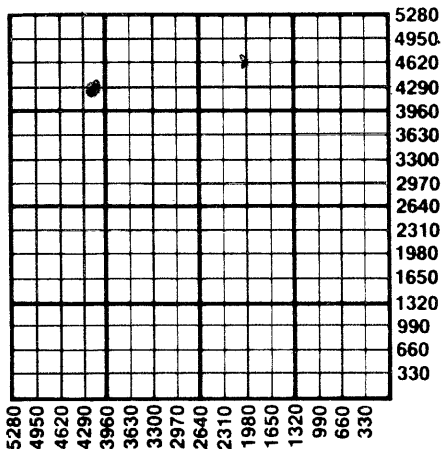

STATE COMPLETION
 878-2011
 NOV 1980
 CONSERVATION DIVISION
 WICHITA, KANSAS

State Corporation Commission of Kansas
 Conservation Division
 200 Colorado Derby Building
 Wichita, Kansas 67202-1212
 (316) 263-3238

11-4-88