

CARD MUST BE TYPED

State of Kansas

CARD MUST BE SIGNED

### NOTICE OF INTENTION TO DRILL

(see rules on reverse side)

Expected Spud Date..... 11/04/88  
month day year

API Number 15- 059 - 24,395-00-00  
APR NE SE NW 03 16 20 — East  
3815 Sec Twp..... S, Rg..... West  
2855 Ft. from South Line of Section  
Ft. from East Line of Section

OPERATOR: License # PAINTER OIL COMPANY  
Name .....  
Address P.O. BOX 141B, RT. 2  
City/State/Zip WELLSVILLE 66092  
Contact Person. MAX PAINTER  
Phone (901) 685-7121

Nearest lease or unit boundary line 330 feet  
County FRANKLIN  
Lease Name. LESTER SCOTT Well # 11  
APX 900

(Note: Locate well on Section Plat on reverse side)

CONTRACTOR: License # SIMPSON DRILLING  
Name .....  
City/State OSAWATOMIE 66064

Ground surface elevation ..... feet MSL  
Domestic well within 330 feet: —yes XX no  
Municipal well within one mile: —yes XX no

Well Drilled For: Well Class: Type Equipment:  
— Oil Storage XX Infield XX Mud Rotary  
— Gas XX Inj — Pool Ext. — Air Rotary  
— OWWO — Expl — Wildcat — Cable

Depth to bottom of fresh water 100  
Depth to bottom of usable water 200  
Surface pipe by Alternate: 40 2 XX  
Surface pipe planned to be set \*\*\*\*\*

If OWWO: old well info as follows:  
Operator .....  
Well Name .....  
Comp Date ..... Old Total Depth.....

Conductor pipe required .....  
Projected Total Depth 760 feet  
Formation SQUIRREL

I certify that well will comply with K.S.A. 55-101, et seq., plus eventually plugging hole to KCC specifications.  
Date 11/04/88 Signature of Operator or Agent Title AS AGENT

For KCC Use:  
Conductor Pipe Required ..... feet; Minimum Surface Pipe Required 20' feet per Alt. X (2)  
This Authorization Expires 5-4-89 Approved By LKM 11-4-88


EFFECTIVE DATE: 11-9-88

Must be filed with the K.C.C. five (5) days prior to commencing well  
 This card void if drilling not started within six (6) months of date received by K.C.C.

**Important procedures to follow:**

1. Notify District office before setting surface casing.
2. Set surface casing by circulating cement to the top.
3. File completion forms ACO-1 with K.C.C. within 120 days of well spud date, following instructions on ACO-1, side 1, and including copies of wireline logs.
4. Notify District office 48 hours prior to old well workover or re-entry.
5. Prior to filing Intent, prepare a proposed plugging plan in case well is D & A, then obtain approval of plan when calling district office prior to setting surface pipe.
6. Submit plugging report (CP-4) to K.C.C. after plugging is completed.
7. Obtain an approved injection docket number before disposing of salt water.
8. Notify K.C.C. within 10 days when injection commences or terminates.
9. If an alternate completion, cement in the production pipe from below any usable water to surface within 120 days of spud date.

**A Regular Section of Land**  
**1 Mile = 5,280 Ft.**

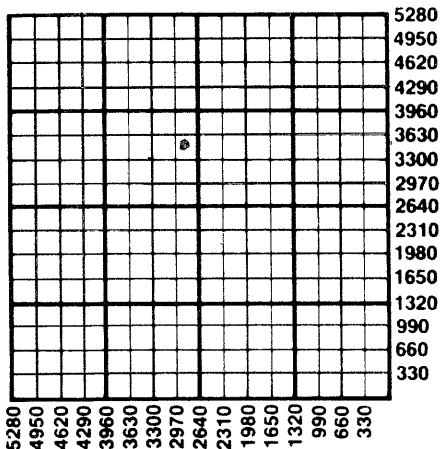

RECEIVED  
 STATE CORPORATION COMMISSION  
 NOV 4 1988  
 CONSERVATION DIVISION  
 Wichita, Kansas

11-4-88

State Corporation Commission of Kansas  
 Conservation Division  
 200 Colorado Derby Building  
 Wichita, Kansas 67202-1212  
 (316) 263-3238