

CARD MUST BE TYPED

State of Kansas
NOTICE OF INTENTION TO DRILL
(see rules on reverse side)

CARD MUST BE SIGNED

Starting Date: 12 5 1984
month day year ~~2:30~~

OPERATOR: License # 6807
Oil Drillers Dev., Inc.
Name
Address 7929 S.W. 29th Street
City/State/Zip Topeka, Ks 66614
Contact Person Dr. Jerry Fegan
Phone 913 354 9591 (X388 Irene)

CONTRACTOR: License #
Company Tools
Name
City/State

Well Drilled For:	Well Class:	Type Equipment:
<input checked="" type="checkbox"/> Oil	<input type="checkbox"/> Swd	<input checked="" type="checkbox"/> Infield
<input type="checkbox"/> Gas	<input type="checkbox"/> Inj	<input type="checkbox"/> Pool Ext.
<input type="checkbox"/> OWWO	<input type="checkbox"/> Expl	<input type="checkbox"/> Wildcat
		<input type="checkbox"/> Mud Rotary
		<input type="checkbox"/> Air Rotary
		<input type="checkbox"/> Cable

If OWWO? old well info as follows:

Operator
Well Name
Comp Date Old Total Depth
Projected Total Depth 800 feet
Projected Formation at TD
Expected Producing Formations

I certify that we will comply with K.S.A. 55-101, et seq., plus eventually plugging hole to K.C.C. specifications.

Date 12/4/84 Signature of Operator or Agent

Elaine Carlson Title

as agent

MHC/KOHE 12/4/84

Form C-1 4/84

API Number 15- 059-23,779-00-20
SE/4 (location) Sec 4 Twp 16 S, Rge 20 East West

495 Ft North from Southeast Corner of Section
165 Ft West from Southeast Corner of Section
(Note: Locate well on Section Plat on reverse side)

Nearest lease or unit boundary line 165 feet
County Franklin
Lease Name Scamom Well# 5

Domestic well within 330 feet: yes no
Municipal well within one mile: yes no

Depth to Bottom of fresh water 148 feet
Lowest usable water formation Kansas City Group
Depth to Bottom of usable water 250 feet
Surface pipe by Alternate: 1 2
Surface pipe to be set 40 feet
Conductor pipe if any required
Ground surface elevation feet MSL
This Authorization Expires 6-4-85
Approved By *[Signature]*

CONSERVATION DIVISION
Wichita, Kansas


DEC 4 1984

Must be filed with the K.C.C. five (5) days prior to commencing well
This card void if drilling not started within six (6) months of date received by K.C.C.

12-4-84

Important procedures to follow:

STATE CONSERVATION COMMISSION
Regular Section of Land
280 Ft.

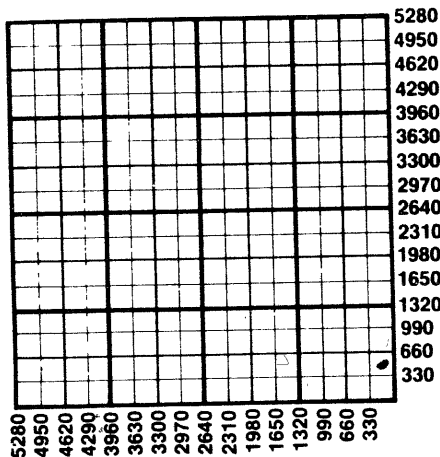

1. Notify District office before setting surface casing.
2. Set surface casing by circulating cement to the top.
3. File completion forms ACO-1 with K.C.C. within 90 days of well completion, following instructions on ACO-1, side 1, and including copies of wireline logs.
4. Notify District office 48 hours prior to old well workover or re-entry.
5. Prior to plugging, prepare a plugging plan, then obtain agreement from the appropriate district office for an approved plugging plan.
6. Submit plugging report (CP-4) to K.C.C. after plugging is completed.
7. Obtain an approved injection docket number before disposing of salt water.
8. Notify K.C.C. within 10 days when injection commences or terminates.
9. If an alternate 2 completion, cement in the production pipe from below any usable water to surface within 120 days of spud date.

State Corporation Commission of Kansas
Conservation Division
200 Colorado Derby Building
Wichita, Kansas 67202
(316)263-3238