

CARD MUST BE TYPED

State of Kansas
NOTICE OF INTENTION TO DRILL
(see rules on reverse side)

CARD MUST BE SIGNED ✓

Starting Date: 7 2 1985
month day year

API Number 15- 059-23,963-00-00

OPERATOR: License # 9873
Name Painter Oil Company
Address 9865 Fairwood Lane
City/State/Zip Memphis, Tennessee 38119
Contact Person Jerry Hardsaw
Phone (913) 242-5332

SW. SW. SE. Sec 4. Twp. 16. S. Rge. 20. East
(location) West

495 Ft North from Southeast Corner of Section
2145 Ft West from Southeast Corner of Section
(Note: Locate well on Section Plat on reverse side)

CONTRACTOR: License # 6807
Name Oil Drillers & Developers
City/State 901 Garfield, Topeka, KS 66606

Nearest lease or unit boundary line 495 feet.

County Franklin
Lease Name Madeline Scott Well# 1

Domestic well within 330 feet: yes no
Municipal well within one mile: yes no

Depth to Bottom of fresh water None feet

Lowest usable water formation feet

Depth to Bottom of usable water 200 feet

Surface pipe by Alternate: 1 2

Surface pipe to be set 40 feet

Conductor pipe if any required feet

Ground surface elevation feet MSL

This Authorization Expires 1-1-86

Approved By 7-1-85 *[Signature]*

I certify that we will comply with K.S.A. 55-101, et seq., plus eventually plugging hole to K.C.C. specifications.

Date 7/1/85 Signature of Operator or Agent

Susan Arnold

Title As Agent

Must be filed with the K.C.C. five (5) days prior to commencing well
 This card void if drilling not started within six (6) months of date received by K.C.C. STATE CORPORATION COMMISSION


RECEIVED

7-1-85

JUL 01 1985

Important procedures to follow:
 CONSERVATION DIVISION

A Regular Section of Land
 1 Mile = 5,280 Ft.

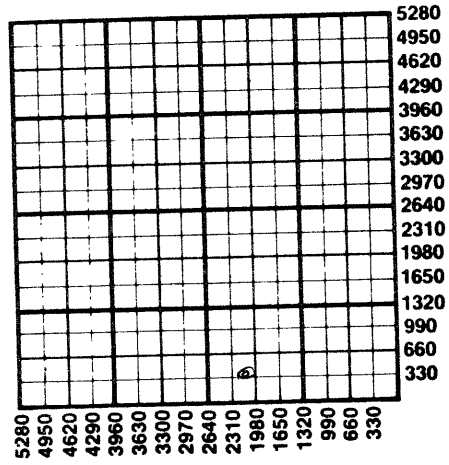

1. Notify District office before setting surface casing. Wichita, Kansas
2. Set surface casing by circulating cement to the top.
3. File completion forms ACO-1 with K.C.C. within 90 days of well completion, following instructions on ACO-1, side 1, and including copies of wireline logs.
4. Notify District office 48 hours prior to old well workover or re-entry.
5. Prior to plugging, prepare a plugging plan, then obtain agreement from the appropriate district office for an approved plugging plan.
6. Submit plugging report (CP-4) to K.C.C. after plugging is completed.
7. Obtain an approved injection docket number before disposing of salt water.
8. Notify K.C.C. within 10 days when injection commences or terminates.
9. If an alternate 2 completion, cement in the production pipe from below any usable water to surface within 120 days of spud date.

State Corporation Commission of Kansas
 Conservation Division
 200 Colorado Derby Building
 Wichita, Kansas 67202
 (316) 263-3238