

CARD MUST BE TYPED

State of Kansas

CARD MUST BE SIGNED

NOTICE OF INTENTION TO DRILL

(see rules on reverse side)

Expected Spud Date..... 6 1 1987
 month day year

OPERATOR: License # 9873
 Name Painter Oil Co., Inc.
 Address 5865 Fairwood Lane
 City/State/Zip Memphis, Tenn. 38119
 Contact Person Joe Smith
 Phone (901) 685-7121

CONTRACTOR: License # 6807
 Name Oil Driller and Developers, Inc.
 City/State 901 Garfield, Topeka, KS 66606

Well Drilled For: Well Class: Type Equipment:
☒ Oil ☐ Storage ☐ Infill ☒ Mud Rotary
☒ Gas ☐ Inj ☐ Pool Ext. ☐ Air Rotary
☐ OWWO ☐ Expl ☒ Wildcat ☐ Cable

If OWWO: old well info as follows:

Operator
 Well Name
 Comp Date Old Total Depth

I certify that well will comply with K.S.A. 55-101, et seq., plus eventually plugging hole to KCC specifications.

Date 6/1/87 Signature of Operator or Agent [Signature] Title AS AGENT

For KCC Use:

Conductor Pipe Required feet; Minimum Surface Pipe Required feet per Alt. 20
 This Authorization Expires 12-1-87 Approved By [Signature] 6-1-87

API Number 15— 059-24,237-00-00
 SE SE SE Sec. 9 Twp. 16 S, Rg. 20
 330 Ft. from South Line of Section
 330 Ft. from East Line of Section

(Note: Locate well on Section Plat on reverse side)

Nearest lease or unit boundary line 330 feet
 County Franklin
 Lease Name Madline Scott Well # 2
 Ground surface elevation n/a feet MSL
 Domestic well within 330 feet: yes no
 Municipal well within one mile: yes no
 Depth to bottom of fresh water
 Depth to bottom of usable water 200
 Surface pipe by Alternate: 1 2 X
 Surface pipe planned to be set 40
 Conductor pipe required
 Projected Total Depth 1000 feet
 Formation Bartlesville


[Signature]

Must be filed with the K.C.C. five (5) days prior to commencing well
This card void if drilling not started within six (6) months of date received by K.C.C.

Important procedures to follow:

1. Notify District office before setting surface casing.
2. Set surface casing by circulating cement to the top.
3. File completion forms ACO-1 with K.C.C. within 120 days of well spud date, following instructions on ACO-1, side 1, and including copies of wireline logs.
4. Notify District office 48 hours prior to old well workover or re-entry.
5. Prior to filing Intent, prepare a proposed plugging plan in case well is D & A, then obtain approval of plan when calling district office prior to setting surface pipe.
6. Submit plugging report (CP-4) to K.C.C. after plugging is completed.
7. Obtain an approved injection docket number before disposing of salt water.
8. Notify K.C.C. within 10 days when injection commences or terminates.
9. If an alternate 2 completion, cement in the production pipe from below any usable water to surface within 120 days of spud date.

A Regular Section of Land
1 Mile = 5,280 Ft.

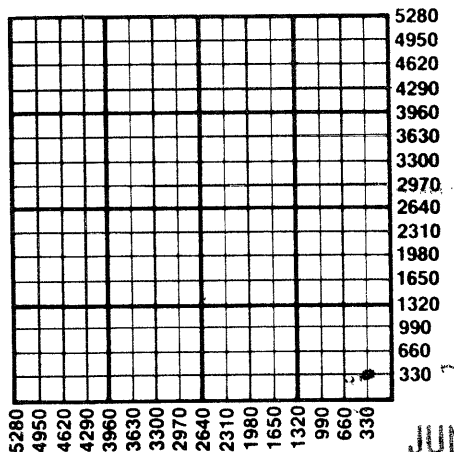

CONSERVATION DIVISION
Wichita, Kansas

State Corporation Commission of Kansas
Conservation Division
200 Colorado Derby Building
Wichita, Kansas 67202-1212
(316) 263-3238

17-1-87