

CARD MUST BE TYPED

State of Kansas

CARD MUST BE SIGNED

NOTICE OF INTENTION TO DRILL

(see rules on reverse side)

Expected Spud Date. OCTOBER 10, 1987 month day year

API Number 15-059-24,273-00-00

OPERATOR: License # #9873 Name PAINTER OIL COMPNY Address BOX 141B, ROUTE 2 City/State/Zip WELLSVILLE, KS 66092 Contact Person JOE SMITH Phone 913-242-7310

SW NW NW Sec 10 Twp 16 Rg 20 East 4019 Ft. from South-Line of Section 4950 Ft. from East Line of Section

(Note: Locate well on Section Plat on reverse side)

CONTRACTOR: License # 6807 Name OIL DRILLERS & DEVELOPERS, INC City/State TOPEKA, KS

Nearest lease or unit boundary line 330 feet County FRANKLIN Lease Name TOM SEYLER Well # 3 Ground surface elevation feet MSL Domestic well within 330 feet: yes X no Municipal well within one mile: yes X no Depth to bottom of fresh water Depth to bottom of usable water 200 Surface pipe by Alternate: 1 X Surface pipe planned to be set 40 Conductor pipe required Projected Total Depth 1050 feet Formation BARTLESVILLE

Well Drilled For: Well Class: Type Equipment: Oil Storage X Infield Mud Rotary Gas Inj Pool Ext Air Rotary OWWO Expl Wildcat Cable

If OWWO: old well info as follows: Operator Well Name Comp Date Old Total Depth

I certify that well will comply with K.S.A. 55-101, et seq., plus eventually plugging hole to KCC specifications.

Date 9/05/87 Signature of Operator or Agent Title AS AGENT


For KCC Use: Conductor Pipe Required feet; Minimum Surface Pipe Required 20 feet per Alt. This Authorization Expires 4-5-88 Effective 10-10-87 Approved By 10-5-87

Must be filed with the K.C.C. five (5) days prior to commencing well  
 This card void if drilling not started within six (6) months of date received by K.C.C.

**Important procedures to follow:**

1. Notify District office before setting surface casing.
2. Set surface casing by circulating cement to the top.
3. File completion forms ACO-1 with K.C.C. within 120 days of well spud date, following instructions on ACO-1, side 1, and including copies of wireline logs.
4. Notify District office 48 hours prior to old well workover or re-entry.
5. Prior to filing Intent, prepare a proposed plugging plan in case well is D & A, then obtain approval of plan when calling district office prior to setting surface pipe.
6. Submit plugging report (CP-4) to K.C.C. after plugging is completed.
7. Obtain an approved injection docket number before disposing of salt water.
8. Notify K.C.C. within 10 days when injection commences or terminates.
9. If an alternate 2 completion, cement in the production pipe from below any usable water to surface within 120 days of spud date.

**A Regular Section of Land**  
**1 Mile = 5,280 Ft.**

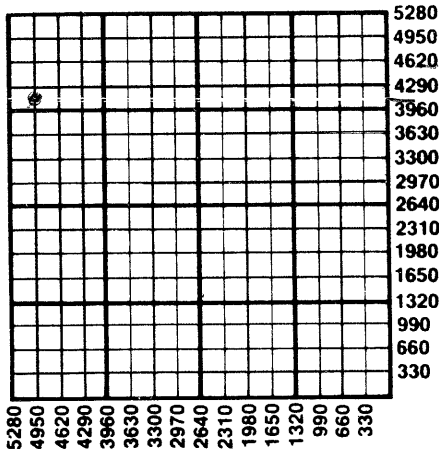

105-87

RECEIVED  
 CONSERVATION DIVISION  
 STATE CORPORATION COMMISSION  
 WICHITA, KANSAS  
 OCT 5 1987  
 State Corporation Commission of Kansas  
 Conservation Division  
 200 Colorado Derby Building  
 Wichita, Kansas 67202-1212  
 (316) 263-3238